


STATE OF KANSAS  
STATE CORPORATION COMMISSION

WELL PLUGGING RECORD

Give All Information Completely  
Make Required Affidavit  
Mail or Deliver Report to:  
Conservation Division  
State Corporation Commission  
211 No. Broadway  
Wichita, Kansas

NORTH

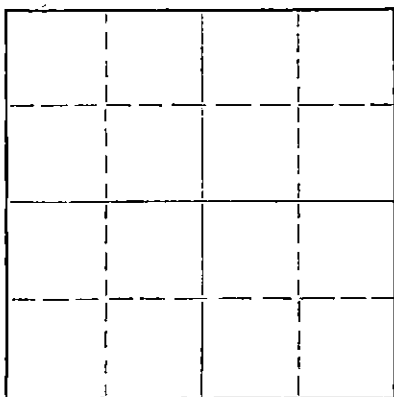

Locate well correctly on above  
Section Plat

Stafford County. Sec. 17 Twp. 24 Rge. 12 (E) (W)  
Location as "NE/CNW%SW%" or footage from lines NE NE NW  
Lease Owner Sierra Petroleum Co., Inc.  
Lease Name TIECHMAN Well No. 1  
Office Address 208 Petroleum Bldg., Wichita, Kansas  
Character of Well (completed as Oil, Gas or Dry Hole) dry  
Date well completed 9/7/58 19  
Application for plugging filed 9/6/58 19  
Application for plugging approved 9/6/58 19  
Plugging commenced 9/7/58 19  
Plugging completed 9/7/58 19  
Reason for abandonment of well or producing formation dry

If a producing well is abandoned, date of last production \_\_\_\_\_ 19\_\_\_\_  
Was permission obtained from the Conservation Division or its agents before plugging was commenced? \_\_\_\_\_

Name of Conservation Agent who supervised plugging of this well \_\_\_\_\_  
Producing formation \_\_\_\_\_ Depth to top \_\_\_\_\_ Bottom \_\_\_\_\_ Total Depth of Well 4100 Feet  
Show depth and thickness of all water, oil and gas formations.

OIL, GAS OR WATER RECORDS

CASING RECORD

FORMATION	CONTENT	FROM	TO	SIZE	PUT IN	PULLED OUT
				8 5/8	268	none

Describe in detail the manner in which the well was plugged, indicating where the mud fluid was placed and the method or methods used in introducing it into the hole. If cement or other plugs were used, state the character of same and depth placed, from \_\_\_\_\_ feet to \_\_\_\_\_ feet for each plug set.

PLUGGING RECORD

Filled hole with heavy mud from 4100 up to 250'. Set bridge using 1/3 sack hulls, wood plug and 20 sacks cement through drill pipe. Filled heavy mud up to 35'. Set bridge using 1/3 sacks hulls, wood plug and 10 sacks cement up to cellar 0. Job complete 7:30 a.m. 9/7/58

(If additional description is necessary, use BACK of this sheet)

Name of Plugging Contractor Sierra Petroleum Co., Inc.  
Address 208 Petroleum Bldg., Wichita, Kansas

STATE OF KANSAS, COUNTY OF RUSSELL, ss.  
C. T. Honaker (employee of owner) or (owner or operator) of the above-described well, being first duly sworn on oath, says: That I have knowledge of the facts, statements, and matters herein contained and the log of the above-described well as filed and that the same are true and correct. So help me God.

(Signature) C. T. Honaker

(Address)

SUBSCRIBED AND SWORN TO before me this 8th day of September, 19 58

My commission expires 1-30-61

Margie Cooper  
Notary Public.

RECEIVED  
STATE CORPORATION COMMISSION  
9-9-58  
SEP 9 1958

PLUGGING  
FILE SEC. 17 T. 24 R. 12  
BOOK PAGE 128 LINE 25  
Wichita Kansas  
CONSERVATION DIVISION

Sierra Petroleum Co., Inc. -

TIECHMAN #1

NE NE NW Sec. 17-24-12  
Stafford County, Kansas

Total Depth: 4100'

Elev: 1892 KB

Comm: 8/25/58

Comp: 9/7/58

Casing:

Cement:

8 5/8 @ 268'

with 250 sacks cement

FORMATION	DEPTH
Sand	155
Shale	268
Shale & Red bed	705
Anhydrite	733
Shale	1140
Shale & lime	1910
Lime	2195
Lime & shale	3520
Lime	3785
Lime & shale	3868
Viola	3873
Chert & Lime	3879
Viola	3918
Lime & Chert	3958
Chert & Dolemite	3983
Chert & Lime	4013
Simpson	4040
Lime	4073
Chert & Lime	4100

Tops:

Anhydrite	705
Heebner	3328
Brown Lime	3480
Lansing K.C.	3507
Viola	3868
Simpson	4005
Arbuckæe	4070

STATE OF KANSAS )  
 ) ss:  
 COUNTY OF RUSSELL )

I hereby certify that the above information is true and correct to the best of my knowledge.

C. P. Hensler

Subscribed and sworn to before me this 8th day of September, 1958.

Margie Cooper  
Notary Public

My commission expires: 1-30-61.

RECEIVED  
 CORPORATION COMMISSION  
 SEP 9 1958  
 DIVISION

PLUGGING
FILE SEC 17 T 24 R 12w
BOOK PAGE 128 LINE 25