


STATE OF KANSAS
STATE CORPORATION COMMISSION

Give All Information Completely
Make Required Affidavit
Mail or Deliver Report to:
Conservation Division
State Corporation Commission
800 Bitting Building
Wichita, Kansas

WELL PLUGGING RECORD

NORTH

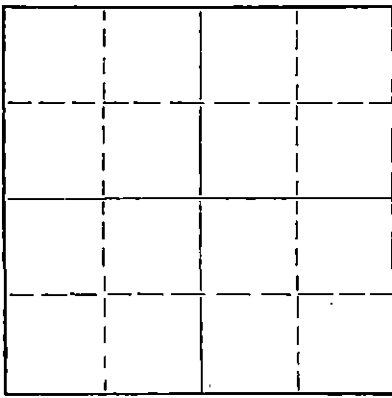

Locate well correctly on above
Section Plat

Stafford County, Sec. 21 Twp 24S Rge. 12W (E) (W)
Location as "NE/CNW/SW" or footage from lines SWSWNE
Lease Owner Stearns Petroleum, Inc.
Lease Name Byer Well No. 1
Office Address Box 313 Russell, Kansas
Character of Well (completed as Oil, Gas or Dry Hole) Dry Hole
Date well completed Feb 6 19 56
Application for plugging filed Feb 6 19 56
Application for plugging approved 19
Plugging commenced Feb 6 19 56
Plugging completed Feb 6 19 56
Reason for abandonment of well or producing formation
Dry Hole
If a producing well is abandoned, date of last production 19
Was permission obtained from the Conservation Division or its agents before plugging was commenced? Yes

Name of Conservation Agent who supervised plugging of this well R. M. Brundage
Producing formation Depth to top Bottom Total Depth of Well 1135 Feet
Show depth and thickness of all water, oil and gas formations.

OIL, GAS OR WATER RECORDS

CASING RECORD

| FORMATION | CONTENT | FROM | TO | SIZE | PUT IN | PULLED OUT |
|-----------|---------|------|----|-------|--------|------------|
| | | | | 8 5/8 | 255 | None |
| | | | | | | |
| | | | | | | |
| | | | | | | |
| | | | | | | |
| | | | | | | |
| | | | | | | |

Describe in detail the manner in which the well was plugged, indicating where the mud fluid was placed and the method or methods used in introducing it into the hole. If cement or other plugs were used, state the character of same and depth placed, from feet to feet for each plug set.

Mud to 265'
20 sacks cement
Mud to 40'
1/2 sack hulls & 10 sacks cement

(If additional description is necessary, use BACK of this sheet)

Name of Plugging Contractor Stearns Petroleum, Inc.
Address Box #313, Russell, Kansas

STATE OF KANSAS, COUNTY OF RUSSELL, ss.
D. G. Comstock (employee of owner) or (owner or operator) of the above-described well, being first duly sworn on oath, says: That I have knowledge of the facts, statements, and matters herein contained and the log of the above-described well as filed and that the same are true and correct. So help me God.

(Signature) *D. G. Comstock*
Box 313, Russell, Kansas
(Address)

SUBSCRIBED AND SWORN TO before me this 5th day of March, 19 56

My commission expires April 5, 1958
Betty Lou Miller Notary Public.

PLUGGING
FILE SEC 21 T 24 R 12W
BOOK PAGE 37 LINE 15

Rec'd
3-7-56

BYER #1

Operator: Stearns Petroleum, Inc.
Contractor: Stearns Petroleum, Inc.
Commencement Date: January 20, 1956
Completion Date: February 6, 1956
Elevation: 1887 R. B.
I. P.: D. & A.


Location:
SW SW NE
Section 21-24-12W
Stafford County, Kansas

Casing Record:

Ran 13 joints of 8-5/8" casing. Cemented with 180 sacks of common cement and 2 sacks of Calcium Chloride.

WELL LOG

| | | |
|-------------------|------|------|
| Cellar | 0 | 5 |
| Shale | 5 | 25 |
| Sand & Red Bed | 25 | 105 |
| Sand | 105 | 135 |
| Shale | 135 | 220 |
| Shale & Shells | 220 | 300 |
| Red Bed and Shale | 300 | 375 |
| Red Bed | 375 | 720 |
| Anhydrite | 720 | 740 |
| Shale & Shells | 740 | 1285 |
| Salt & Shale | 1285 | 1420 |
| Shale & Shells | 1420 | 1600 |
| Shale & Lime | 1600 | 1650 |
| Lime | 1650 | 1680 |
| Lime & Shale | 1680 | 2000 |
| Lime | 2000 | 2060 |
| Lime & Shale | 2060 | 2090 |
| Lime | 2090 | 2160 |
| Lime & Shale | 2160 | 2445 |
| Shale & Shells | 2445 | 2800 |
| Shale | 2800 | 2810 |
| Lime & Shale | 2810 | 3105 |
| Lime | 3105 | 3270 |
| Lime & Shale | 3270 | 3570 |
| Lime | 3570 | 3758 |
| Shale & Shells | 3758 | 3775 |
| Shale & Lime | 3775 | 3815 |
| Shale | 3815 | 3850 |
| Shale & Shells | 3850 | 3876 |
| Shale & Lime | 3876 | 3905 |
| Shale | 3905 | 3923 |
| Lime | 3923 | 3954 |
| Lime & Chert | 3954 | 3975 |
| Lime | 3975 | 4004 |
| Chert | 4004 | 4020 |
| Lime & Shale | 4020 | 4023 |
| Lime | 4023 | 4038 |
| Lime & Shale | 4038 | 4106 |
| Shale | 4106 | 4116 |
| Lime | 4116 | 4135 |
| Total Depth | 4135 | |

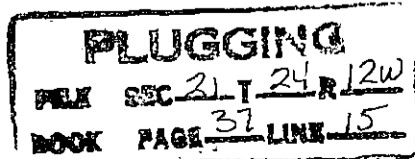

| | | | |
|-------|---------------------|------|-------|
| Tops: | Anhydrite | 720 | 1167 |
| | Heebner | 3336 | -1449 |
| | Toronto | 3353 | -1446 |
| | Brown Lime | 3491 | -1604 |
| | Lansing-Kansas City | 3520 | -1633 |
| | Base L-Kansas City | 3760 | -1873 |
| | Kinderhook | 3835 | -1948 |
| | Viola | 3923 | -2036 |
| | Simpson Shale | 4032 | -2145 |
| | Simpson Sand | 4069 | -2182 |
| | Arbuckle | 4116 | -2229 |
| | R. T. D. | 4135 | -2248 |

STATE OF KANSAS)
) SS:
 COUNTY OF RUSSELL)

I hereby certify that the above information is true and correct to the best of my knowledge.

O. G. Stearns
 O. G. Stearns, President

SUBSCRIBED AND SWORN to before me, a Notary Public this 15th day of February, 1956.

Betty Lou Miller
 Betty Lou Miller, Notary Public

My Commission Expires:

April 5, 1958

PLUGGING
 FILE SEC. 21 T. 24 R. 12W
 BOOK PAGE 37 LINE 15

ST
 100
 100
 100
 100