


STATE OF KANSAS  
STATE CORPORATION COMMISSION

WELL PLUGGING RECORD

Give All Information Completely  
Make Required Affidavit  
Mail or Deliver Report to:  
Conservation Division  
State Corporation Commission  
211 No. Broadway  
Wichita, Kansas

Stafford County. Sec. 21 Twp. 24S Rge. (E) 12 (W)  
Location as "NE/CNW/SW" or footage from lines NW SE NE  
Lease Owner Stickle Drilling Company  
Lease Name Byer Well No. 2  
Office Address 1100 Bitting Bldg., Wichita, Kansas  
Character of Well (completed as Oil, Gas or Dry Hole) Dry hole.  
Date well completed May 21 19 66  
Application for plugging filed 19  
Application for plugging approved 19  
Plugging commenced 19  
Plugging completed 19  
Reason for abandonment of well or producing formation -

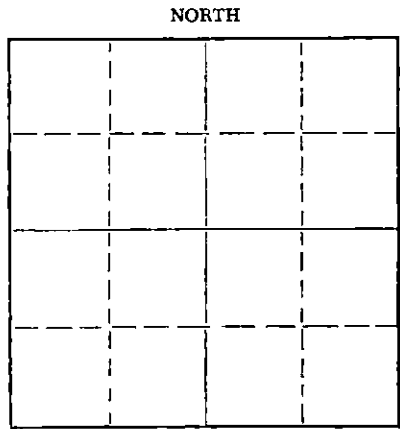

Locate well correctly on above  
Section Plat

If a producing well is abandoned, date of last production - 19  
Was permission obtained from the Conservation Division or its agents before plugging was commenced? Yes

Name of Conservation Agent who supervised plugging of this well  
Producing formation \_\_\_\_\_ Depth to top \_\_\_\_\_ Bottom \_\_\_\_\_ Total Depth of Well 3939 Feet  
Show depth and thickness of all water, oil and gas formations.

OIL, GAS OR WATER RECORDS					CASING RECORD	
FORMATION	CONTENT	FROM	TO	SIZE	PUT IN	PULLED OUT
Surface Sands	Water			8-5/8"	247'	None

RECEIVED  
STATE CORPORATION COMMISSION  
MAY 25 1966  
CONSERVATION DIVISION  
WICHITA, KANSAS

Describe in detail the manner in which the well was plugged, indicating where the mud fluid was placed and the method of methods used in introducing it into the hole. If cement or other plugs were used, state the character of same and depth placed, from \_\_\_\_\_ feet to \_\_\_\_\_ feet for each plug set.

Heavy rotary mud was placed from TD to 230'.  
At 230' a Howco plug, hulls, and 25 sacks of cement were placed through the drill pipe.  
Heavy rotary mud was placed to 40 feet.  
At 40 feet a Howco plug and hulls were then used to fill the casing.  
Two sacks of cement were placed in the rat hole and two sacks in the mouse hole.

(If additional description is necessary, use BACK of this sheet)  
Name of Plugging Contractor Stickle Drilling Company  
Address 1100 Bitting Building, Wichita, Kansas 67202

STATE OF KANSAS, COUNTY OF SEDGWICK, ss.  
R. B. Parriott (employee of owner) or (owner or operator) of the above-described well, being first duly sworn on oath, says: That I have knowledge of the facts, statements, and matters herein contained and the log of the above-described well as filed and that the same are true and correct. So help me God.

(Signature) R. B. Parriott  
R. B. Parriott  
1100 Bitting Building, Wichita, Kansas  
(Address)

SUBSCRIBED AND SWORN TO before me this 24th day of May, 19 66  
Charley V. Shank  
Charley V. Shank, Notary Public.  
My commission expires 17 February 1970

Stickle Drilling Company  
Wichita, Kansas

Drig. Contractor: Stickle Drilling Company, No. 2 Byer  
Date Commenced: 13 May 1966 NW SE NE 21-24S-21W  
Date Completed: 20 May 1966 Stafford County, Kansas

DRILLER'S LOG

Depth figures indicate base of formation:

Sand and Red Bed	248
Red Bed	690
Anhydrite	744
Red Bed	1160
Shale	1773
Shale and Lime	2025
Lime	2180
Shale and Shells	2545
Lime and Shale	2770
Shale and Shells	3000
Shale and Lime	3181
Lime and Shale	3234
Lime	3351
Lime and Shale	3589
Lime	3689
Lime and Chert	3712
Lime	3885
Shale	3935
Chert and Lime	3939 RTD


RECEIVED  
STATE CORPORATION COMMISSION

MAY 25 1966

CONSERVATION DIVISION  
Wichita, Kansas

I, R. B. Parriott, hereby certify that to the best of my knowledge and belief, the above is a true and complete Driller's Log of Stickle's No. 2 Byer, in Stafford County, Kansas.

  
R. B. Parriott

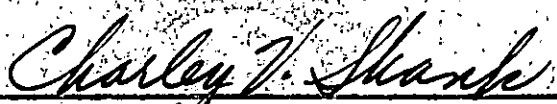  
Charley V. Shank, Notary Public  
My Commission Expires 17 February 1970