

STATE OF KANSAS  
STATE CORPORATION COMMISSION

WELL PLUGGING RECORD

Give All Information Completely  
Make Required Affidavit  
Mail or Deliver Report to:  
Conservation Division  
State Corporation Commission  
211 No. Broadway  
Wichita, Kansas

Stafford County. Sec. 21 Twp. 24 Rge. 12 (E) W (W)

Location as "NE/CNW/SW" or footage from lines. SE/4 SE/4 NW/4

Lease Owner Clay H Newell

Lease Name Clay H Newell - Piepmeir Well No. 1

Office Address Stafford, Kansas.

Character of Well (completed as Oil, Gas or Dry Hole) Producer.

Date well completed \_\_\_\_\_ 19 \_\_\_\_\_

Application for plugging filed \_\_\_\_\_ 19 \_\_\_\_\_

Application for plugging approved \_\_\_\_\_ 19 \_\_\_\_\_


Plugging commenced February 14 19 57

Plugging completed Feb. 25 19 57

Reason for abandonment of well or producing formation \_\_\_\_\_

If a producing well is abandoned, date of last production \_\_\_\_\_ 19 \_\_\_\_\_

Was permission obtained from the Conservation Division or its agents before plugging was commenced? yes.

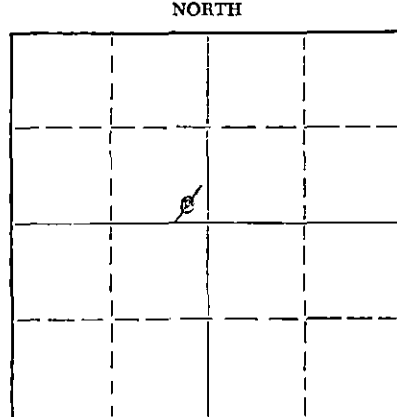

Locate well correctly on above Section Plat

Name of Conservation Agent who supervised plugging of this well Russell Brundage

Producing formation \_\_\_\_\_ Depth to top \_\_\_\_\_ Bottom \_\_\_\_\_ Total Depth of Well 4140 Feet

Show depth and thickness of all water, oil and gas formations.

OIL, GAS OR WATER RECORDS

CASING RECORD

FORMATION	CONTENT	FROM	TO	SIZE	PUT IN	PULLED OUT

Describe in detail the manner in which the well was plugged, indicating where the mud fluid was placed and the method or methods used in introducing it into the hole. If cement or other plugs were used, state the character of same and depth placed, from 4140 feet to surface feet for each plug set.

Hole filled with sand from 4140 to 4095; Five sacks of cement placed in hole with dump bailer; pipe pulled from hole, and hole filled with mud to 240 feet; ten foot rock bridge installed and twenty sacks of cement poured in hole, and hole mudded to 30 feet; five foot rock bridge installed between 30 and 25 feet and hole capped with five sacks of cement.

(If additional description is necessary, use BACK of this sheet)

Name of Plugging Contractor BARNES AND SONS PIPE PULLING Co., Russell, Kans.

Address \_\_\_\_\_

STATE OF Kansas, COUNTY OF Stafford, ss.

Clay H Newell (employee of owner) or (owner or operator) of the above-described well, being first duly sworn on oath, says: That I have knowledge of the facts, statements, and matters herein contained and the log of the above-described well as filed and that the same are true and correct. So help me God.

(Signature) Clay H. Newell  
Stafford, Kansas  
(Address)

SUBSCRIBED AND SWORN TO before me this 6 day of March, 19 57

[Signature] Notary Public.

My commission expires Aug. 5 - 1958

PLUGGING  
FILE SEC. 21 T. 24 R. 12W  
BOOK PAGE 141 LINE 14

RECEIVED  
STATE CORPORATION COMMISSION  
MAR 7 - 1957  
3-7-57  
STATE CORPORATION COMMISSION

February 15, 1957

State Corporation Commission of Kansas  
211 North Broadway  
Wichita, Kansas

Dear Sir:

Enclosed is a check for \$25.00 for permit to plug the No. 1 Piepmeier in Stafford County, Location of the well is in the SE-SE-NW Of Sec. 21-24S-12W. This well had 240 feet of Surface pipe set with 200 sacks of cement, 4140 feet of 5½ pipe set with 75 sacks of cement, perforation is open from 4107 to 4109, all of the other perforations were squeezed off 2 years ago, I hope this is all the information you need, if not please advise.

Yours very truly

*C. A. Newell*

RECEIVED  
STATE CORPORATION COMMISSION  
FEB 16 1957  
CONSERVATION DIVISION  
Wichita, Kansas

PLUGGING  
FILE SEC 21 T 24 R 12 W  
BOOK PAGE 141 LINE 14