


STATE OF KANSAS
STATE CORPORATION COMMISSION

Give All Information Completely
Make Required Affidavit
Mail or Deliver Report to:
Conservation Division
State Corporation Commission
212 North Market, Insurance Bldg.
Wichita, Kansas

WELL PLUGGING RECORD

NORTH

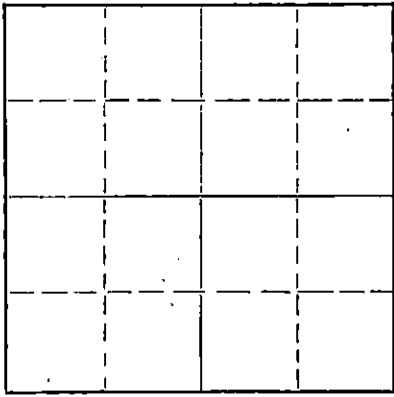

Locate well correctly on above
Section Plat

Stafford County, Sec. 21 Twp. 24S Rge. 12 (E) W (W)
Location as "NE/CNW%SW%" or footage from lines SW NE SW
Lease Owner Rex & Morris Drilling Company, et al.
Lease Name Gard Well No. 1
Office Address Box 334, El Dorado, Kansas
Character of Well (completed as Oil, Gas or Dry Hole) Dry Hole
Date well completed December 29 19 58
Application for plugging filed " " 19 58
Application for plugging approved " " 19 58
Plugging commenced " " 19 58
Plugging completed " " 19 58
Reason for abandonment of well or producing formation Dry Hole

If a producing well is abandoned, date of last production _____ 19____
Was permission obtained from the Conservation Division or its agents before plugging was commenced? Yes

Name of Conservation Agent who supervised plugging of this well _____
Producing formation None Depth to top _____ Bottom _____ Total Depth of Well 4130 Feet
Show depth and thickness of all water, oil and gas formations.

OIL, GAS OR WATER RECORDS				CASING RECORD		
FORMATION	CONTENT	FROM	TO	SIZE	PUT IN	PULLED OUT
Surface Hole	Water	0	368	8 5/8"	368	None
(See attached log)						

Describe in detail the manner in which the well was plugged, indicating where the mud fluid was placed and the method or methods used in introducing it into the hole. If cement or other plugs were used, state the character of same and depth placed, from _____ feet to _____ feet for each plug set.

Mud from 4130' to 300': 20 sacks of cement on bridge @ 300': Filled with mud to 35':
Bridge at 35' with 10 sacks cement to surface: 2 sacks cement in rat hole.

RECEIVED
STATE CORPORATION COMMISSION
JAN 9 1959
CONSERVATION DIVISION
Wichita, Kansas

(If additional description is necessary, use BACK of this sheet)
Name of Plugging Contractor Rex & Morris Drilling Company
Address Box 334, El Dorado, Kansas

STATE OF Kansas, COUNTY OF Butler, ss.
C. E. McClure (employee of owner) or (owner or operator) of the above-described well, being first duly sworn on oath, says: That I have knowledge of the facts, statements, and matters herein contained and the log of the above-described well as filed and that the same are true and correct. So help me God.

(Signature) C. E. McClure
Box 334, El Dorado, Kansas
(Address)

SUBSCRIBED AND SWORN TO before me this 8th day of January, 19 59

My commission expires August 8, 1962

Elizabeth Deschner
Notary Public.

PLUGGING
FILE SEC21 T. 24 R. 12W
BOOK PAGE 10 LINE 23

Elevation 1892 R. B.
1889 D. F.

GARD WELL # 1

Osage Oil & Gas Company, Inc.
and
Rex & Morris Drilling Company

Total Depth: 4130'
Contractor: Rex & Morris Drilling Co.
Commenced: 12-16-58
Completed: 12-29-58
Initial Production: D. & A.

Location: SW NE SW
Section 21-24S-12W
Stafford County, Kansas
Casing Record:
8 5/8" @ 368' w/250 sacks

FORMATION	DEPTH
Surface Hole	368'
Shale	700'
Lime	730
Shale	1385
Shale and Lime	1875
Lime and Shale	2450
Shale and Lime	2740
Lime and Shale	3110
Lime	3235
Lime and Shale	3350
Shale and Lime	3524
Lime	3806
Shale and Lime	3951
Chert	3955
Lime	3965
Lime (Cherty)	4045
Lime	4057
Shale	4080
Sand	4085
Shale and Sand	4115
Shale	4125
Lime	4130

R. T. D.

RECEIVED
STATE CORPORATION COMMISSION
JAN 9 1959
CONSERVATION DIVISION
Wichita, Kansas

I hereby certify the foregoing statements are true and correct to the best of my knowledge and belief.

Rex & Morris Drilling Company

By Paul D. Koontz
Paul D. Koontz, Geologist

PLUGGING
FILE SEC. 21 T. 24 R. 12W
BOOK PAGE 10 LINE 23

STATE OF KANSAS
COUNTY OF BUTLER, SS.

Subscribed and sworn to before me, a Notary Public, this 9th day of January, 1959.

Elizabeth Deschner
Elizabeth Deschner, Notary Public

My commission expires: August 8, 1962