


### WELL PLUGGING RECORD

Give All Information Completely  
Mails Required Affidavit  
Mail or Deliver Report to:  
Conservation Division  
State Corporation Commission  
211 No. Broadway  
Wichita, Kansas

Stafford County, Sec. 10 Twp. 24 Rge. 12 (E) (W)  
Location as "NE/CNW%SW%" or footage from lines. Se NW SE

Lease Owner E. K. Edmiston  
Lease Name Byers Well No. 1  
Office Address Wichita, Kansas  
Character of Well (completed as Oil, Gas or Dry Hole) Dry Hole  
Date well completed 9/13/62 19\_\_  
Application for plugging filed 10/17/62 19\_\_  
Application for plugging approved 19\_\_  
Plugging commenced 10/18/62 19\_\_  
Plugging completed: 10/24/62 19\_\_  
Reason for abandonment of well or producing formation \_\_\_\_\_

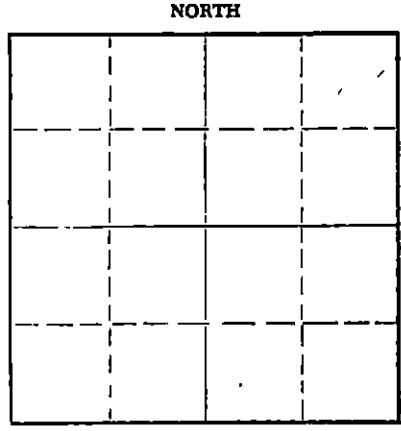

Locate well correctly on above Section Plat

If a producing well is abandoned, date of last production \_\_\_\_\_ 19\_\_  
Was permission obtained from the Conservation Division or its agents before plugging was commenced? Yes

Name of Conservation Agent who supervised plugging of this well Le Kamp  
Producing formation \_\_\_\_\_ Depth to top \_\_\_\_\_ Bottom \_\_\_\_\_ Total Depth of Well \_\_\_\_\_ Feet  
Show depth and thickness of all water, oil and gas formations.

OIL, GAS OR WATER RECORDS				CASING RECORD		
FORMATION	CONTENT	FROM	TO	SIZE	PUT IN	PULLED OUT

Describe in detail the manner in which the well was plugged, indicating where the mud fluid was placed and the method or methods used in introducing it into the hole. If cement or other plugs were used, state the character of same and depth placed, from \_\_\_\_\_ feet to \_\_\_\_\_ feet for each plug set.  
Plugged back to 3600 ft. put 20 gal sand 2 bailers cement.  
Hole wouldn't bail down set rock bridge and dumper 4 sacks cement  
Pumped in 10 sacks mud and 71 sacks cement.

**RECEIVED**  
STATE CORPORATION COMMISSION  
  
FEB 1 1963  
2-1-63  
CONSERVATION DIVISION  
Wichita, Kansas

Name of Plugging Contractor Central Pipe Pulling Co. (If additional description is necessary, use BACK of this sheet)  
Address 1416 Coolidge Great Bend, Kansas

STATE OF KANSAS, COUNTY OF SEDGWICK, ss. E. K. Edmiston (Employee of Owner) or (owner) or operator) of the above-described well, being first duly sworn on oath, says: That I have knowledge of the facts, statements, and matters herein contained and the log of the above-described well as filed and that the same are true and correct. So help me God.

(Signature) [Signature]  
501 First Nat'l. Bk. Bldg., Wichita, Kansas (Address)

SUBSCRIBED AND SWORN TO before me this 19th day of January, 1963  
My commission expires April 23, 1963  
Juanita M. Green Notary Public.

DRILLER'S LOG

COMPANY: E. K. EDMISTON  
 501 FIRST NATIONAL BANK BUILDING  
 WICHITA 2, KANSAS

ROTARY DRILLING COMMENCED: AUGUST 21, 1962

ROTARY DRILLING COMPLETED: AUGUST 31, 1962

WELL NAME: BYERS NO. 1  
 SE NW SE SEC. 10-24-12W  
 STAFFORD COUNTY, KANSAS

CONTRACTOR: E. K. EDMISTON DRILLING CO., INC.  
 501 FIRST NATIONAL BANK BUILDING  
 WICHITA 2, KANSAS

CASING RECORD: 8 5/8" @ 213' w/ 200 sacks

LOG

Measurements from top of Rotary Bushing:

0 -	40	Surface Soil and Clay
40 -	90	Sand
90 -	215	Shale and Shells
215 -	336	Shale
336 -	400	Shale
400 -	643	Red Bed and Shale
643 -	675	Anhydrite
675 -	1007	Shale
1007 -	1645	Shale
1645 -	1858	Shale and Lime
1858 -	2045	Lime and Shale
2045 -	2290	Lime
2290 -	2861	Lime and Shale
2861 -	3036	Shale and Lime
3036 -	3185	Lime and Shale
3185 -	3280	Lime
3280 -	3509	Lime and Shale
3509 -	3885	Lime
	<u>3885</u>	<u>Rotary Total Depth</u>

**RECEIVED**  
 STATE CORPORATION COMMISSION  
 FEB 1 1963  
 CONSERVATION DIVISION  
 Wichita, Kansas

The undersigned, E. K. Edmiston, President of the E. K. Edmiston Drilling Company, Inc., hereby certifies, in behalf of said company that the above log is a true and correct log of the formations encountered in drilling the above well as reflected by the Daily Drilling Reports.

E. K. Edmiston Drilling Co., Inc.

By [Signature]  
 E. K. Edmiston, President

STATE OF KANSAS )  
 )  
 COUNTY OF SEDGWICK ) ss:

BE IT REMEMBERED that, on this 6th day of September, 1962, before me, the undersigned, a Notary Public duly commissioned in and for the State and County aforesaid, came E. K. Edmiston, known to me to be the same person who executed the foregoing instrument as President and in behalf of the E. K. Edmiston Drilling Company, Inc. and he duly acknowledged the execution of the same for himself and for said company.

IN WITNESS WHEREOF, I have hereunto set my hand and official seal on the day and year last above written.

[Signature]  
 Juanita M. Green, Notary Public

My Commission Expires:  
 April 23, 1963