

STATE OF KANSAS
STATE CORPORATION COMMISSION

WELL PLUGGING RECORD

Give All Information Completely
Make Required Affidavit
Mail or Deliver Report to
Conservation Division
State Corporation Comm.
245 North Water
Wichita, KS 67202

Stafford County. Sec. 7 Twp. 24 Rge. 13 E/W
Location as "NE/CNW $\frac{1}{4}$ SW $\frac{1}{4}$ " or footage from lines
NE SE NE

Lease Owner Icer Addis
Lease Name Henderson Well No. 1
Office Address P. O. Drawer 8038 Wichita, Kans. 67208
Character of Well (Completed as Oil, Gas or Dry Hole)


Dry hole

Date Well completed Dec. 4 1978
Application for plugging filed Dec. 4 1978
Application for plugging approved Dec. 4 1978
Plugging commenced 1:00 A.M. Dec. 4 1978
Plugging completed 2:15 A.M. Dec. 4 1978
Reason for abandonment of well or producing formation

If a producing well is abandoned, date of last production 19

Was permission obtained from the Conservation Division or its agents before plugging was commenced? yes
Bill Owens

Name of Conservation Agent who supervised plugging of this well
Producing formation Depth to top Bottom Total Depth of Well 4167'
Show depth and thickness of all water, oil and gas formations.

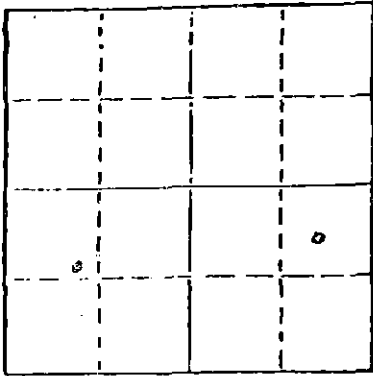

Locate well correctly on above Section Plot

OIL, GAS OR WATER RECORDS

CASING RECORD

FORMATION	CONTENT	FROM	TO	SIZE	PUT IN	PULLED OUT

Describe in detail the manner in which the well was plugged, indicating where the mud fluid was placed and the method or methods used in introducing it into the hold. If cement or other plugs were used, state the character of same and depth placed, from feet to feet for each plug set.

540' w/50 sx 50/50 Pozmix
240' w/240sx " "
40' w/40 sx " "
3 Sx. in rat hole

RECEIVED
STATE CORPORATION COMMISSION
12-11-78
DEC 11 1978

CONSERVATION DIVISION
Wichita, Kansas

(If additional description is necessary, use BACK of this sheet)

Name of Plugging Contractor

STATE OF Kansas COUNTY OF Barton
Larry Curtis (employee of owner) or (owner or operator)
of the above-described well, being first duly sworn on oath, says: That I have knowledge of the facts, statements, and matters herein contained and the log of the above-described well as filed and that the same are true and correct. So help me God.

(Signature) Larry Curtis

(Address)

SUBSCRIBED AND SWORN TO before me this 6th day of December 6, 1978

Bessie M. Dewerff Notary Public.

My commission expires 5-20-81

BESSIE M. DEWERFF
STATE NOTARY PUBLIC
BARTON COUNTY, KANSAS
APPT. EXP. 5-20-81

DRILLERS WELL LOG

L. D. DRILLING COMPANY - CONTRACTOR
HENDERSON # 1
NE SE NE 7-24-13
STAFFORD COUNTY, KANSAS

ICER ADDIS - OPERATOR
T. D. 4167
ELEV.

COMMENCED: 11-25-78
COMPLETED: 12-4-78

Casing:

8-5/8" set at 243'

Cement:

W/200 sx 50/50 Pozmix, 2% Gel, 3% CC

FORMATION

Sand & Shale
Lime & Shale
Shale
Lime

DEPTH

0 - 234
234 - 3412
3412 - 3416
3416 - 4167

TOPS

Anhy.	808
Heeb.	3412
Toronto	3431
Douglas	3438
Brn. Lime	3551
Lansing	3576
B K/c	3838
Cong.	3916
Viola	3946
Simpson	4088
Simpson Sand	4098
Arb.	4131
T.D.	4167

RECEIVED
STATE CORPORATION COMMISSION
DEC 11 1978
CONSERVATION DIVISION
Wichita, Kansas

AFFIDAVIT

STATE OF KANSAS COUNTY OF BARTON

I, Larry Curtis of the L. D. Drilling Company

being first duly sworn on oath, State: That I have knowledge of the facts statements and matters herein contained and that the same are true and correct.

Larry Curtis
Larry Curtis

Subscribed and sworn to before me on this 8th day of December 1978

My commission expires: 5-20-81

Bessie M. DeWerff
Notary Public: Bessie M. DeWerff

BESSIE M. DEWERFF
STATE NOTARY PUBLIC
BARTON COUNTY, KANSAS
MY APPT. EXP. 5-20-81