

STATE OF KANSAS
STATE CORPORATION COMMISSION


Give All Information Completely
Make Required Affidavit
Mail or Deliver Report to:
Conservation Division
State Corporation Commission
800 Bitting Building
Wichita, Kansas

WELL PLUGGING RECORD

Stafford County, Sec. 7 Twp. 24 Rge. 13 (E) (W)

Location as "NE/CNW/SW" or footage from lines SE SE SW
Lease Owner Pam-Kar Drlg Co., Inc.
Lease Name Rixon Well No. 1
Office Address 333 First Natl Bldg, Wichita, Kans
Character of Well (completed as Oil, Gas or Dry Hole) Drl Hole
Date well completed April 26 19 53
Application for plugging filed April 26 19 53
Application for plugging approved April 26 19 53
Plugging commenced April 26 19 53
Plugging completed April 26 19 53
Reason for abandonment of well or producing formation

NORTH

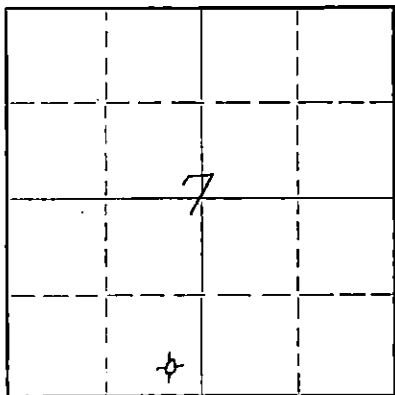

Locate well correctly on above Section Plat

If a producing well is abandoned, date of last production 19
Was permission obtained from the Conservation Division or its agents before plugging was commenced? Yes

Name of Conservation Agent who supervised plugging of this well Merl Rize
Producing formation Depth to top Bottom Total Depth of Well 4190 Feet
Show depth and thickness of all water, oil and gas formations.

OIL, GAS OR WATER RECORDS

CASING RECORD

FORMATION	CONTENT	FROM	TO	SIZE	PUT IN	PULLED OUT
				8-5/8"	237'	None
				No Oil	String Run	

Describe in detail the manner in which the well was plugged, indicating where the mud fluid was placed and the method or methods used in introducing it into the hole. If cement or other plugs were used, state the character of same and depth placed, from feet to feet for each plug set.

Mudded hole to 237'. Set Plug. Cemented through drill pipe with 20 sks Cement. Mudded hole to 35'. Cemented with 10 Sks. Cement. All plugs secured with 2 strands .066 Howco Steel line.

STATE CORPORATION COMMISSION
MAY 5 1953
5-5-53
CONSERVATION DIVISION
WICHITA, KANSAS

(If additional description is necessary, use BACK of this sheet)
Name of Plugging Contractor Pam-Kar Drlg Co
Address 333 First Natl Bank Bldg, Wichita, Kansas

STATE OF KANSAS, COUNTY OF SEDGWICK, ss.
W. S. Brunson (employee of owner) or (owner or operator) of the above-described well, being first duly sworn on oath, says: That I have knowledge of the facts, statements, and matters herein contained and the log of the above-described well as filed and that the same are true and correct. So help me God.

(Signature) W. S. Brunson

SUBSCRIBED AND SWORN TO before me this 27th day of April, 19 53

(Address) June J. Stewart
Notary Public.

My commission expires January 6, 1954

PLUGGING
FILE SEC-2724R 134
BOOK PAGE-22 LINE 7

PAM-KAR DRILLING COMPANY, INC.

Wichita, Kansas

Well: Rixon #1

SE 1/4 SW, Sec 7-24-13W
Stafford County, Kansas

Commenced RD : 4-11-53
Completed RD : 4-26-53
Total Depth : 4190'

Elevation: 1928 DF
1931 KB

Casing: 237' 8-5/8" OD 24# 3rd Tnd
No Oil String Run

Contractor: Pam-Kar Drlg Co.

STRATA	DEPTH		TOPS	
Surface Soil	20	Heebner	3419	-1488
Sand & Gravel	120	Brown Lias	3553	-1622
Light grey shale	192	Lansing	3582	-1651
Sand, rock & Pyrite	194	Miss Chert	3873	-1962
Red shale	239	Viola Chert	3970	-2039
Shale & Red Bed	435	Simpson Shale	4108	-2177
Sand & Shale	635	Simpson Sand	4124	-2193
Sand & Red Bed	828	Arbuckle	4162	-2231
Chalk	850			
Anhydrite	861			
Shale & Red Bed	980			
Shale & Shells	1330			
Shale- salt	1410			
Shale - shells	1667			
Broken lime	1925			
Lime	2050			
Shale & Lime	2085			
Shale & Shells	2225			
Lime & shale	2325			
Shale & lime	2690			
Shale & lime shells	2893			
Lime & shale	3865			
Lime, chert & shale	3972			
Shale, sand - lime	4020			
Lime & chert	4075			
DST	4075 - 4085			
Lime & shale	4173			
Arbuckle	4190			
TOTAL DEPTH	4190			

I hereby certify that the above is a true and correct log of said well as reflected by the Daily Drilling Reports.

PAM-KAR DRILLING COMPANY, INC.

By

Ralph B. McLaughlin

Signed and sworn to in my presence this 27th day of April, 1953, by
Ralph B. McLaughlin, Secretary-Treasurer
of the Pam-Kar Drilling Company, Inc. a corporation in the State of Kansas.

Irvin J. Stewart
Notary Public

My commission expires Jan 6, 1954.

THE COMMISSIONER OF CONSERVATION
MAY - 5 - 53
CONSERVATION DIVISION
Wichita, Kansas

PLUGGING
WELL SEC 7 T 24 R 13W
BOOK PAGE 98 LINE 7