

STATE OF KANSAS
STATE CORPORATION COMMISSION

Form CP-4


Give All Information Completely
Make Required Affidavit
Mail or Deliver Report to:
Conservation Division
State Corporation Commission
212 No. Market
Wichita, Kansas

WELL PLUGGING RECORD

STAFFORD County. Sec. 6 Twp. 24s Rge. 13 (E) (W)

Location as "NE/CNW/SW" or footage from lines NW SE NW
Lease Owner PETROLEUM, INC.,
Lease Name ENGLISH Well No. 1
Office Address R.R. #2, GREAT BEND, KANSAS
Character of Well (completed as Oil, Gas or Dry Hole) DRY HOLE
Date well completed JANUARY 26 19 67
Application for plugging filed JANUARY 26 19 67
Application for plugging approved JANUARY 26 19 67
Plugging commenced JANUARY 26 19 67
Plugging completed JANUARY 26 19 67
Reason for abandonment of well or producing formation NO PRODUCIBLE ZONE

NORTH

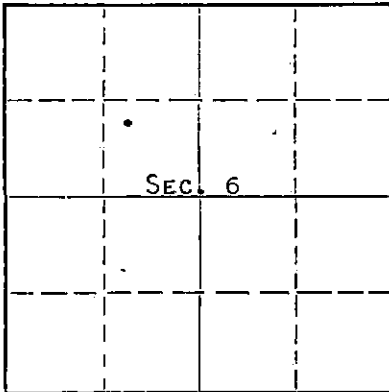

Locate well correctly on above
Section Plat

If a producing well is abandoned, date of last production NONE 19
Was permission obtained from the Conservation Division or its agents before plugging was commenced? YES

Name of Conservation Agent who supervised plugging of this well ARCHIE ELVING
Producing formation _____ Depth to top _____ Bottom _____ Total Depth of Well 3550 Feet
Show depth and thickness of all water, oil and gas formations.

OIL, GAS OR WATER RECORDS

CASING RECORD

FORMATION	CONTENT	FROM	TO	SIZE	PUT IN	PULLED OUT
				8-5/8"	248'	NONE

Describe in detail the manner in which the well was plugged, indicating where the mud fluid was placed and the method or methods used in introducing it into the hole. If cement or other plugs were used, state the character of same and depth placed, from _____ feet to _____ feet for each plug set.

MUD TO 230', ROLL UP 1/4 SACK HULLS IN SACK AND PUSH W/PLUG TO 230', ADD 25 SACKS CEMENT THRU DRILL PIPE. MUD TO 40', BRIDGE W/1 SACK DRY CEMENT, 1/2 SACK HULLS, WOODEN PLUG, PLACED 10 SACKS CEMENT ON TOP OF PLUG TO BASE OF WELL CELLAR.

STATE CORPORATION COMMISSION

FEB 17 1967

2-17-67

CONSERVATION DIVISION
Wichita, Kansas

(If additional description is necessary, use BACK of this sheet)

Name of Plugging Contractor GARVEY DRILLING COMPANY
Address R.R. #2, GREAT BEND, KANSAS

STATE OF KANSAS, COUNTY OF BARTON, ss.
MONTE CHADD (employee of owner) or (owner) of the above-described well, being first duly sworn on oath, says: That I have knowledge of the facts, statements, and matters herein contained and the log of the above-described well as filed and that the same are true and correct. So help me God. MONTE CHADD, DIST. PROD. SUPT.

(Signature) *Monte Chadd*
R.R. #2, GREAT BEND, KANSAS
(Address)

SUBSCRIBED AND SWORN to before me this 15 day of FEBRUARY, 19 67.

My commission expires MAY 28, 1969 *Richard H. Dumbles* Notary Public.

WELL LOG

COMPANY Petroleum, Inc.

SEC. 6 T. 24S R. 13W

FARM English No. 1


LOC. NW SE NW

TOTAL DEPTH 3550'

COUNTY Stafford

COMM. 1-21-67 COMP. 1-26-67

CONTRACTOR Garvey Drilling Company

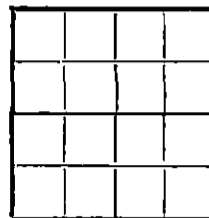

CASING 8 5/8" @ 248' w/265 sx

ELEVATION 1904' DF

PRODUCTION D & A

FIGURES INDICATE BOTTOM OF FORMATIONS

140' Top Soil, Sand and Shale
255' Shale and Shells
755' Red Bed
892' Shale
930' Anhydrite
1100' Shale
1770' Shale and Shells with Lime Streaks
1865' Shale and Lime
2135' Lime and Shale
2965' Shale and Lime
3180' Lime and Shale
3350' Shale and Lime
3444' Lime
3550' Shale
3550' RTD

RECORDED
STATE COMMISSION COMMISSIONER
FEB 17 1967
COMMISSION DIVISION
WICHITA, KANSAS

State of Kansas }
County of Barton } SS

I, Sam N. Stephens of Garvey Drilling Company

upon oath state the above and foregoing is a true and correct copy of the log of the English No. 1 well.

Subscribed and sworn to before me this 14th day of February 19 67

My Commission Expires: November 5th, 1969

Richard L. Boyce
NOTARY PUBLIC