


STATE OF KANSAS
STATE CORPORATION COMMISSION

WELL PLUGGING RECORD

Give All Information Completely
Make Required Affidavit
Mail or Deliver Report to:
Conservation Division
State Corporation Commission
211 No. Broadway
Wichita, Kansas

Stafford County. Sec. 6 Twp. 24 Rge. 13 (X) W (W)
Location as "NE/CNW/SW" or footage from lines. NE NW NE
Lease Owner PETROLEUM, INC.
Lease Name HUNT Well No. 3
Office Address Route 2, Great Bend, Kansas
Character of Well (completed as Oil, Gas or Dry Hole) Oil
Date well completed October 5, 1950
Application for plugging filed August 2, 1957
Application for plugging approved August 8, 1957
Plugging commenced September 16, 1957
Plugging completed September 20, 1957

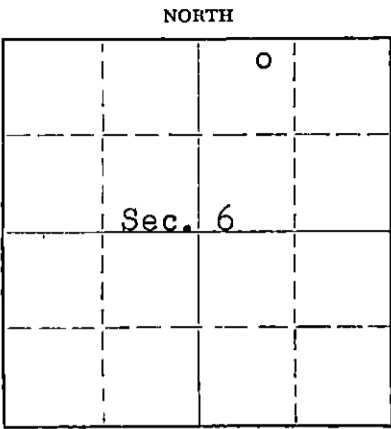

Locate well correctly on above Section Plat

Reason for abandonment of well or producing formation Depletion of producible zones
If a producing well is abandoned, date of last production February 16 19 57
Was permission obtained from the Conservation Division or its agents before plugging was commenced? Yes

Name of Conservation Agent who supervised plugging of this well R.M. Brundage Hoisington, Kansas
Producing formation Kansas City Depth to top 3556' Bottom --- Total Depth of Well 3683 Feet
Show depth and thickness of all water, oil and gas formations.

OIL, GAS OR WATER RECORDS

CASING RECORD

FORMATION	CONTENT	FROM	TO	SIZE	PUT IN	PULLED OUT
Kansas City	Water and little oil	3681'	3683'	8-5/8" 5-1/2"	326' 3681'	None 3100'

Describe in detail the manner in which the well was plugged, indicating where the mud fluid was placed and the method or methods used in introducing it into the hole. If cement or other plugs were used, state the character of same and depth placed, from _____ feet to _____ feet for each plug set.

Filled hole with crushed rock from 3683' to 3670' and placed 5 sacks cement on top of rock. Globe Oil Well Cementing Co. pumped 25 sacks Davis Gel (mud) on top of cement followed by a plug. Filled hole to base of well cellar with 80 sacks cement, 2 sacks calcium chloride. Checked well the following morning and found cement 50' down, Mudded up to 15' followed by 5 sacks cement to base of well cellar.

Rec'd
10-2-57

(If additional description is necessary, use BACK of this sheet)

Name of Plugging Contractor Morgan Well Plugging Service
Address 102 West 18th Street, Hutchinson, Kansas

STATE OF KANSAS, COUNTY OF BARTON, ss.
Don Searle (employee of owner) or (owner/operator) of the above-described well, being first duly sworn on oath, says: That I have knowledge of the facts, statements, and matters herein contained and the log of the above-described well as filed and that the same are true and correct. So help me God.

(Signature) Don Searle

(Address)

SUBSCRIBED AND SWORN TO before me this 24th day of September 19 57

Notary Public. [Signature]

My commission expires July 11, 1960

PLUGGING
FILE SEC. 6 T. 24 R. 13W
BOOK PAGE 33 LINE 14

WELL LOG HUNT #3

Petroleum, Inc., Lease Owner

Section 6, Twp. 24S, Rge. 14W

Garvey Oil, Contractor

Location: NE NW NE

Rotary Total Depth: 3688'

County: Stafford, Kansas

Commenced: 9-16-50

Elevation: 1917 D.F.

Completed: 9-27-50

Casing: 314' of 8 5/8"
3681' of 5 1/2"

Figures below indicate bottom of formation:

110	Clay & Sand	3588	Shale & Lime
175	Shale & Sand	3640	Lime
190	Pyrite		
215	Shale & Shells	3688	R.T.D.
282	Shale		
294	Sand		
317	Shale & Shells		
786	Shale & Red Bed	786	Anhydrite
810	Anhydrite	3394	Heebner
915	Red Bed and Shale	3414	Toronto
1312	Shale & Shells	3434	Base Oread
1310	Salt & Shale	3528	Brown Lime
1705	Shale & Shells	3556	Lansing
1855	Shale & Lime		
2145	Lime		
2270	Lime & Shale		
2405	Shale & Shells		
3115	Shale & Lime		
3204	Brown Lime		
3214	Lime		
3275	Lime & Shale		
3314	Lime		
3437	Lime & Shale		
3523	Lime		

Tops

D.S.T. #1, 3677-88, gas in 9 min., open one hour, closed 15 min., recovered 1040' of gassy oil.

I hereby certify that this is a true and correct log of the above mentioned well.

PETROLEUM, INC.

STATE OF KANSAS:

RECEIVED
STATE CORPORATION COMMISSION

Eric H. Jager
Eric H. Jager

SEDGWICK COUNTY:

OCT 2 - 1957

Subscribed to and sworn to before me, a Notary Public in said County and State this 10th day of October, 1950.

Marjorie Bradshaw
Notary Public

My commission expires: October 27, 1952

PLUGGING	
FILE SEC.	6 T. 24 R. 13W
BOOK PAGE	33 LINE 14