

STATE OF KANSAS  
STATE CORPORATION COMMISSION

WELL PLUGGING RECORD

Give All Information Completely  
Make Required Affidavit  
Mail or Deliver Report to:  
Conservation Division  
State Corporation Commission  
800 Bittling Building  
Wichita, Kansas

STAFFORD County. Sec. 11 Twp. 24 Rge. 14 EST (E) (W)

Location as "NE/CNW/SW" or footage from lines SW SW NE

Lease Owner BEN F. BRACK OIL CO INC.

Lease Name PORTER Well No. 1

Office Address 309-10 BROWN BLDG. WICHITA, KANSAS.

Character of Well (completed as Oil, Gas or Dry Hole) DRY HOLE

Date well completed 6-18 19 49

Application for plugging filed 6-17 19 49

Application for plugging approved 6-17 19 49


Plugging commenced 6-18 19 49

Plugging completed 6-18 19 49

Reason for abandonment of well or producing formation dry

If a producing well is abandoned, date of last production 19

Was permission obtained from the Conservation Division or its agents before plugging was commenced? YES

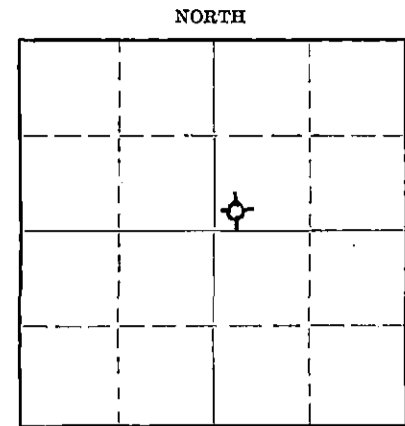

Locate well correctly on above Section Plat

Name of Conservation Agent who supervised plugging of this well E.R. PETTY

Producing formation ARB-- NONE Depth to top Bottom Total Depth of Well Feet

Show depth and thickness of all water, oil and gas formations.

OIL, GAS OR WATER RECORDS

CASING RECORD

Formation	Content	From	To	Size	Put In	Pulled Out
SURFACE SOIL, SAND SHALE SHELLS	DRY	0	217	8 5/8	217	none

Describe in detail the manner in which the well was plugged, indicating where the mud fluid was placed and the method or methods used in introducing it into the hole. If cement or other plugs were used, state the character of same and depth placed, from 210 feet to 25 feet for each plug set.

GUNNED PITS AND FILLED HOLE THRU DRILL PIPE TO BASE OF SURFACE PIPE WITH HEAVY MUD. PLUG AT 210 FEET AND 15 SAX OF CEMENT ON TOP OF SAME. FILLED WITH HEAVY MUD TO 25 FEET AND PLUG AT 25 FEET. 10 SAX CEMENT ON TOP OF SAME.

RECEIVED  
6-21-49  
JUN 21 1949  
CONSERVATION DIVISION  
WICHITA, KANSAS

(If additional description is necessary, use BACK of this sheet)  
Correspondence regarding this well should be addressed to BEN F. BRACK OIL CO INC.  
Address 309-10 BROWN BLDG. WICHITA, KANSAS.

STATE OF KANSAS, COUNTY OF SEDGWICK, ss.

W.J. HALL (employee of owner) or (owner or operator) of the above-described well,

being first duly sworn on oath, says: That I have knowledge of the facts, statements, and matters herein contained and the log of the above-described well as filed and that the same are true and correct. So help me God.

(Signature) W.J. Hall

St. Bernard, Kansas (Address)

SUBSCRIBED AND SWORN to before me this 18 th day of JUNE, 19 49

Pauline B. Suckler Notary Public.

My commission expires November 5, 1951.

PLUGGING  
FILE SEC-1/LT-4 R(40)  
BOOK PAGE 10 LINE 3

BEN F. BRACK OIL COMPANY, INC.  
 309-10 BROWN BUILDING  
 WICHITA, KANSAS

Porter #1 - SW SW NE of Section 11, Township 24 South, Range 14 West,  
 Stafford County, Kansas

WELL LOG

TOTAL DEPTH:	4232'
Comm: 5-28-49	Comp: 6-18-49
Cellar	5'
Surface Soil and Sand	90
Shells, Blue Clay, Shale	217
Clay, Red Bed and Sand	525
Red Bed, Shale & Shells	1035
Shale, Shells, Red Bed	1285
Shale & Shells	1540
Shale & Shells	1770
Lime and Shale	1875
Lime and Shale	1980
Lime and Shale	2050
Shale and Shells	2200
Lime and Shale	2275
Lime and Shale	2340
Lime and Shale	2435
Lime and Shale	2520
Shale and Lime	2615
Shale and Lime	2695
Shale and Lime	2790
Shale and Lime	2895
Shale and Lime	2975
Lime and Shale	3045
Shale and Lime	3140
Shale and Lime	3220
Lime and Shale	3295
Lime	3350
Lime	3395
Lime	3450
Lime	3495
Lime	3520
Lime and Shale Streaks	3555
Lime and Shale	3619
Lime	3665
Lime	3693
Lime	3719
Lime	3752
Chert and Lime	3767
Lime	3802
Lime	3842
Lime	3874
Lime	3896
Lime	3926
Lime	3958
Lime and Shale	3993
Lime	4012
Chert and Lime	4036
Sand	4043
Lime	4051
Lime and Shale	4079
Lime, Shale and Sand	4089
Lime	4092
Chert and Shale	4136
Chert and Lime	4150
Lime, Shale and Sand	4178
Shale and Lime	4201
Lime	4228
Lime	4232
TOTAL DEPTH	4232

DATED: June 22, 1949

Witness: Pauline Hudson

RECEIVED  
 JUN 23 1949  
 CONSERVATION DEPT.

To the best of my knowledge the above is a true and correct record of the formations and depths at which found.

BEN F. BRACK OIL COMPANY, INC.

By Ben F. Brack

PLUGGING  
 SEC 11 - Tot. Row  
 PAGE 10 of LINE 3