


STATE OF KANSAS. STATE CORPORATION COMMISSION

Give All Information Completely Make Required Affidavit Mail or Deliver Report to: Conservation Division State Corporation Commission 800 Bitting Building Wichita, Kansas

WELL PLUGGING RECORD

Stafford County, Sec. 11 Twp. 24 Rge. 14 (E) W (W) Location as "NE/CNW 1/4 SW 1/4" or footage from lines 1750 ft from NW Line 330' from S Line Lease Owner John Lindas Oil, Inc. Lease Name Koelsch Well No. B.4 Office Address 1316 Union National Bank Bldg., Wichita, Kansas Character of Well (completed as Oil, Gas or Dry Hole) Dry Hole Date well completed 5-5-51 Application for plugging filed 5-5-51 Application for plugging approved 5-5-51 Plugging commenced 5-5-51 Plugging completed 5-5-51 Reason for abandonment of well or producing formation Dry If a producing well is abandoned, date of last production 19 Was permission obtained from the Conservation Division or its agents before plugging was commenced? Mr. Durkee

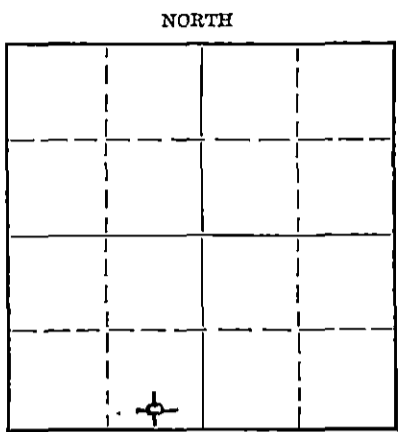

Name of Conservation Agent who supervised plugging of this well Producing formation Depth to top Bottom Total Depth of Well 4060 Feet Show depth and thickness of all water, oil and gas formations.

OIL, GAS OR WATER RECORDS

CASING RECORD

Table with 7 columns: Formation, Content, From, To, Size, Put In, Pulled Out. Row 1: 8 5/8", 402, None.

Describe in detail the manner in which the well was plugged, indicating where the mud fluid was placed and the method or methods used in introducing it into the hole. If cement or other plugs were used, state the character of same and depth placed, from feet to feet for each plug set.

Filled hole with heavy mud to 300' set Plug, and 20 sacks cement. Filled hole with mud to 30' and set plug, 10 sacks cement.

(If additional description is necessary, use BACK of this sheet)

Correspondence regarding this well should be addressed to John Lindas Oil, Inc. Address 1316 Union National Bank Bldg., Wichita, Kansas

STATE OF Kansas, COUNTY OF Sedgwick, ss. E. M. Callaway (employee of owner) or (owner or operator) of the above-described well, being first duly sworn on oath, says: That I have knowledge of the facts, statements, and matters herein contained and the log of the above-described well as filed and that the same are true and correct. So help me God.

(Signature) E. M. Callaway

(Address)

SUBSCRIBED AND SWORN to before me this 11th day of May, 1951

Mabel Tally Notary Public.

My commission expires February 11, 1954

23-5091-s 8-50-10M

PLUGGING FILE SEC-111-24-2142 BOOK PAGE-81 LINE-4

MAY 12 1951 DONALD W. STUBBS Notary Public Wichita, Kansas

DRILLING LOG

*Corporation  
Commission*

To: John Lindas Oil, Inc. etal  
1316 Union National Bank Building  
Wichita 2, Kansas

County: Stafford, Kansas  
Section: 11-24S-11W  
Location: ~~SE-SW-SW~~ *CS/2 SE SW*  
Elevation: 1946 D.F.

Lease: Koelsch "B" #4

Rotary Total Depth: 4060'  
Commenced: 4-20-51. Completed: 5-5-51.  
Casing: 8-5/8" @ 402' with 225 sacks of Cement and 3 sacks of Calcium Chloride.  
5-1/2" @ None Dry Hole and Abandoned.

Contractor: John Lindas Oil, Inc.  
1316 Union National Bank Building  
Wichita 2, Kansas

Figures Indicate Bottom of Formations

0	to	105	Clay Sand
105		390	Shale Sand
390		402	Shale
402		870	Shale and Red Bed
870		880	Red Bed
880		910	Anhydrite
910		1875	Shale Shells
1875		1970	Shale and Lime
1970		2490	Lime Shale
2490		2580	Lime
2580		2900	Shale Lime Streaks
2900		3350	Shale and Lime
3350		3385	Lime and Shale
3385		4060 T.D.	Lime.

STATE OF KANSAS )  
                          ) ss  
COUNTY OF SEDGWICK )

I, the undersigned, being duly sworn on oath, state that the above statement and log is a true and correct record and log of the well drilled at the location above described.

JOHN LINDAS OIL, INC.

*J. Lindas*  
\_\_\_\_\_

Subscribed and sworn to before me, this 9th day of May, 1951.

*Mabel Tally*  
\_\_\_\_\_  
Notary Public

My commission expires the 11th day of February, 1954.

**RECEIVED**  
STATE CORPORATION COMMISSION  
MAY 10 1951  
CONSERVATION DIVISION  
Wichita, Kansas

**PLUGGING**  
FILE SEC 11 T 24 R 14W  
BOOK PAGE 81 LINE 4