


STATE OF KANSAS  
STATE CORPORATION COMMISSION

Form CP-4

Give All Information Completely  
Make Required Affidavit  
Mail or Deliver Report to:  
Conservation Division  
State Corporation Commission  
211 No. Broadway  
Wichita, Kansas

WELL PLUGGING RECORD

Stafford County, Sec. 11 Twp. 24 Rge. 14 (W)  
Location as "NE/CNW/SW" or footage from lines NW1 - NW1 - SW1  
Lease Owner Wichita Iron & Metals Corp  
Lease Name Koelsch Well No. 3  
Office Address Wichita  
Character of Well (completed as Oil, Gas or Dry Hole) Oil  
Date well completed 04-19 1951  
Application for plugging filed 1/22/68 19    
Application for plugging approved 1/31/68 19    
Plugging commenced 2-23 1968  
Plugging completed 2-29 1968  
Reason for abandonment of well or producing formation non-commercial

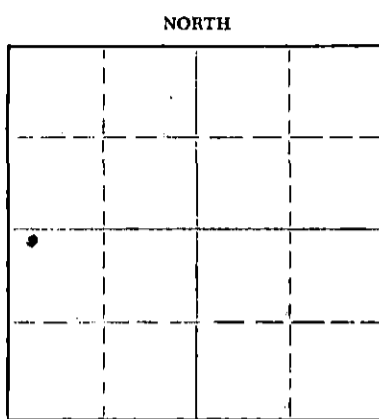

Locate well correctly on above Section Flat

If a producing well is abandoned, date of last production 1/29/64 19    
Was permission obtained from the Conservation Division or its agents before plugging was commenced? Yes

Name of Conservation Agent who supervised plugging of this well Archie Claring  
Producing formation KC - Lansing Depth to top \_\_\_\_\_ Bottom \_\_\_\_\_ Total Depth of Well 4050 Feet  
Show depth and thickness of all water, oil and gas formations.

OIL, GAS OR WATER RECORDS CASING RECORD

FORMATION	CONTENT	FROM	TO	SIZE	PUT IN	PULLED OUT
				8 3/4	426'	none
				5 1/2	4049	2075

Describe in detail the manner in which the well was plugged, indicating where the mud fluid was placed and the method or methods used in introducing it into the hole. If cement or other plugs were used, state the character of same and depth placed, from \_\_\_\_\_ feet to \_\_\_\_\_ feet for each plug set.

filled with sand 3850' to 3475' run 5 sacks of cement from 3475' to 3445', set plug at 300' rock 300' to 290' run 25 sacks of cement 290' to 215', mudd out 215' to 30' rock and 10 sacks of cement 30' to base of cellar.

RECEIVED  
STATE CORPORATION COMMISSION  
3-7-68  
MAR 7 - 1968  
CONSERVATION DIVISION  
Wichita, Kansas

Name of Plugging Contractor Glen & Smith Pipe Laying Co.  
Address Elliswood, Kansas

STATE OF Kansas COUNTY OF Sedgewick, ss.

Ray Stekall (employee of owner) or (owner or operator) of the above-described well, being first duly sworn on oath, says: That I have knowledge of the facts, statements, and matters herein contained and the log of the above-described well as filed and that the same are true and correct. So help me God.

(Signature) Nicholas Iron & Metals Corp  
by Ray Stekall  
Box 13021 - Wichita, Kansas  
(Address)

SUBSCRIBED AND SWORN TO before me this 6th day of March, 1968

My commission expires Dec. 22, 1970  
Evelyn V. North Notary Public.

COPY


WELL LOG BUREAU - KANSAS GEOLOGICAL SOCIETY.  
508 East Murdock, Wichita, Kansas.

Company - JOHN LINDAS OIL, INC.  
Farm - Koelsch "B" No. 3

SEC. 1E. T. 24 N14W  
NW NW SW

Total Depth. 4050  
Comm. 4-5-51 Comp. 4-19-51  
Shot or Treated.  
Contractor. John Lindas, Inc.  
Issued. 7-7-51

County. Stafford  
KANSAS

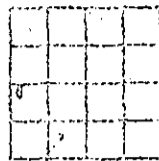

Elevation. 1953 D.E.M.

CASING:  
8 5/8" 426: cem w/225 sx.  
5 1/2" 4049'

Production. 203 bbls.

Figures indicate Bottom of Formations.

clay, sand	90
shale, shells	250
shale	370
sand	380
shale red bed	870
anhydrite	900
shale, shells	1900
shale, lime	1975
lime shale	2425
shale, lime streaks	2600
shale, lime shells	2820
shale, lime	2940
lime	3020
lime, shale streaks	3140
lime	4050
Total Depth	RTD

Scout Tops:	
Lansing	3638
Conglomerate	4000
Viola	4016