


STATE OF KANSAS
STATE CORPORATION COMMISSION
Give All Information Completely
Make Required Affidavit
Mail or Deliver Report to:
Conservation Division
State Corporation Commission
800 Bittling Building
Wichita, Kansas

WELL PLUGGING RECORD
OR
FORMATION PLUGGING RECORD

Strike out upper line
when reporting plug-
ging off formations.

NORTH R-12 W

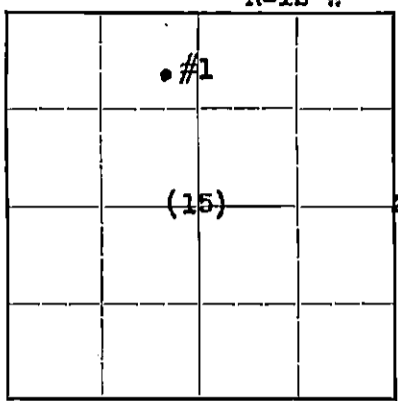

Locate well correctly on above
Section Plat

Stafford County, Sec. 15 Twp. 24S Rge. (E) 12 (W)
Location as "NE 1/4 NW 1/4 SW 1/4" or footage from lines. E 1/2 NE 1/4 NW 1/4
Lease Owner Stanolind Oil and Gas Company
Lease Name John F. Rolfs Well No. 1
Office Address Box 591, Tulsa, Oklahoma
Character of Well (completed as Oil, Gas or Dry Hole) Dry Hole
Date well completed June 10 19 42
Application for plugging filed June 18 19 42
Application for plugging approved June 18 19 42
Plugging commenced August 8 19 42
Plugging completed August 8 19 42
Reason for abandonment of well or producing formation non-productive

If a producing well is abandoned, date of last production 19
Was permission obtained from the Conservation Division or its agents before plugging was com-
menced? yes

Name of Conservation Agent who supervised plugging of this well Mr. C. T. Alexander
Producing formation Viola Depth to top 3861 Bottom 3964 Total Depth of Well 4037 Feet
Show depth and thickness of all water, oil and gas formations. P.B.T.D. 3864

OIL, GAS OR WATER RECORDS

CASING RECORD

Formation	Content	From	To	Size	Put In	Pulled Out
Viola	Dry	3861	3964	5 1/2"	3885	1829
Simpson	Dry	3964	4023			
Arbuckle	Dry	4023	4037			

Describe in detail the manner in which the well was plugged, indicating where the mud fluid was placed and the method or methods used in
introducing it into the hole. If cement or other plugs were used, state the character of same and depth placed, from feet to
feet for each plug set.

Cement 3864 to 3843'
Heavy mud 3843 to 267'
Set solid bridge at 267'
16 sacks cement 267' to 217'
Mud 217' to 40'
14 sacks cement 40' to 5'
Soils 5' to surface

PLUGGING
FILE 15 24-12W
BOOK PAGE 38 LINE 11


(If additional description is necessary, use BACK of this sheet)

Correspondence regarding this well should be addressed to Stanolind Oil and Gas Company
Address Box No. 591, Tulsa, Oklahoma

STATE OF Kansas, COUNTY OF Stafford, ss.

G. B. Snyder (employee of owner) or (owner of operator) of the above-described well,
being first duly sworn on oath, says: That I have knowledge of the facts, statements, and matters herein contained and the log of the above-
described well as filed and that the same are true and correct. So help me God.

(Signature) G. B. Snyder
Field Superintendent
Route #2, Stafford, Kansas
(Address)

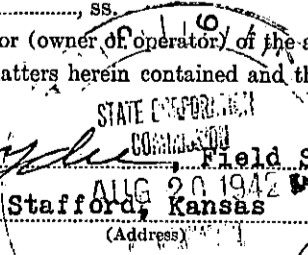

SUBSCRIBED AND SWORN to before me this 19th day of August, 1942

My commission expires February 6, 1946

Rec'd
8-20-42

FORMATION RECORD

Give detailed description and thickness of all formations drilled through and contents of sand, whether dry, water, oil or gas.

Formation	Top	Bottom	Formation	Top	Bottom
Cellar	0	4' 10"			
Surface Clay & Sand	4' 10"	72'			
Surface Sand & Red bed	72	385			
Red Bed & Shale	385	445			
Red Bed	445	670			
Anhydrite	670	694			
Shale & Red bed	694	955			
Salt & Shale	955	1290			
Shale & Shells	1290	1490			
Shale & Lime	1490	1633			
Sand & Lime	1633	1710			
Lime & Anhydrite	1710	1760			
Lime	1760	1859			
Lime & Shale	1859	1900			
Lime	1900	1970			
Shale & Lime	1970	2415			
Lime	2415	2495			
Shale & Lime	2495	2825			
Broken Lime	2825	2864			
Lime	2864	2900			
Shale & Lime	2900	3047			
Lime	3047	3319			
Lime & Shale	3319	3424			
Lime	3424	3460			
Lime & Shale	3460	3506			
Lime	3506	3588			
Lime & Hard chert	3588	3602			
Lime	3602	3748			
Shale	3748	3783			
Lime - hard	3783	3808			
Lime & Shale	3808	3815			
Shale	3815	3855			
Lime, chert & shale	3855	3869			
Lime - cherty	3869	3964			
Shale	3964	4023			
Arbuckle	4023	4037			
Total Depth	4037				