

STATE OF KANSAS
STATE CORPORATION COMMISSION

WELL PLUGGING RECORD


OR
FORMATION PLUGGING RECORD

Strike out upper line when reporting plugging of formations.

Give All Information Completely
Make Required Affidavit
Mail or Deliver Report to:
Conservation Division
State Corporation Commission
800 Bitting Building
Wichita, Kansas

Stafford County. Sec. 15 Twp 24S Rge. 12W (E) (W)
Location as "NE $\frac{1}{4}$ NW $\frac{1}{4}$ SW $\frac{1}{4}$ " or footage from lines NE - NE - SW
Lease Owner Plains Exploration Company
Lease Name Jenkins Well No. 1
Office Address 524 University Bldg., Denver 2, Colorado
Character of Well (completed as Oil, Gas or Dry Hole) Dry Hole
Date well completed 8-9-46 19
Application for plugging filed 8-9-46 19
Application for plugging approved 8-9-46 19
Plugging commenced 8-9-46 19
Plugging completed 8-9-46 19
Reason for abandonment of well or producing formation Dry Hole

NORTH

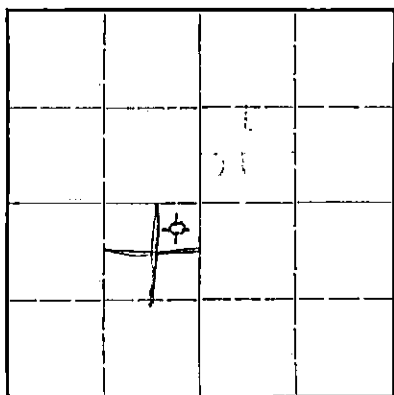

Locate well correctly on above Section Plat

If a producing well is abandoned, date of last production 19
Was permission obtained from the Conservation Division or its agents before plugging was commenced? Yes

Name of Conservation Agent who supervised plugging of this well Kerr
Producing formation None Depth to top Bottom Total Depth of Well 3877 Feet
Show depth and thickness of all water, oil and gas formations.

OIL, GAS OR WATER RECORDS

CASING RECORD

Formation	Content	From	To	Size	Put In	Pulled Out
<u>Viola</u>	<u>Water</u>	<u>3864'</u>	<u>3877'</u>	<u>8 5/8"</u>	<u>261'</u>	<u>None</u>

Describe in detail the manner in which the well was plugged, indicating where the mud fluid was placed and the method or methods used in introducing it into the hold. If cement or other plugs were used, state the character of same and depth placed, from feet to feet for each plug set.


Hole filled with heavy mud from 3877' to 269'

15 Sks. Cement put through Drill Pipe from 260' to 210'

Heavy mud from 210' to 20' below cellar base

Wood plug d rove to 20' below base of cellar

and hole filled with cement to base of cellar.

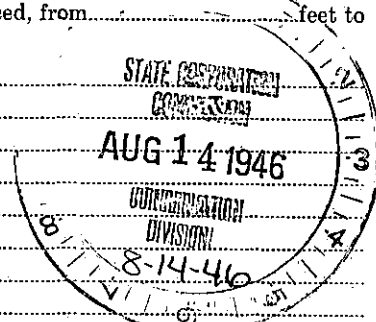

FILE NO. 15-24-12W
BOOK PAGE 66-38

(If additional description is necessary, use BACK of this sheet)

Correspondence regarding this well should be addressed to
Address Plains Exploration Company, Box 273, Stafford, Kansas.

STATE OF Kansas, COUNTY OF Stafford, ss.
E. E. Duncan (employee of owner) or (owner or operator) of the above-described well, being first duly sworn on oath, says: That I have knowledge of the facts, statements, and matters herein contained and the log of the above-described well as filed and that the same are true and correct. So help me God.
(Signature) E. E. Duncan
Stafford, Kansas. (Address)

SUBSCRIBED AND SWORN to before me this 12th day of August 19 46

My commission expires Aug 4 - 1950 Notary Public.

PLAINS EXPLORATION COMPANY

DRILLERS WELL LOG, JENKINS #1.

CONTRACTOR --- STERLING DRILLING COMPANY
COMMENCED --- 7-23-46
SHOT OR TREATED --- No.
PRODUCTION --- NONE
TOTAL DEPTH -- 3877
COMPLETED ** 8-9-46

SEC. 15 - T. 24S - R. 12W
LOC. C - NE - NE - SW
COUNTY --- STAFFORD
ELEVATION --- ---
ALL MEASUREMENTS FROM KELLY BUSHING.


CASING RECORD

8 5/8" at 271' Cemented with 135 sks.

0' Kelly Bushing
190' Surface sand and gravel
680' Red Bed
710' Anhydrite
1250' Red Bed and Shale
1535' Shale and Salt
1680' Shale and Lime
2075' Lime
2195' Broken Lime
2360' Lime and Shale
2430' Lime Broken
2455' Shale
2750' Lime and Shale
2800' Lime
3010' Lime and Shale
3305' Lime
3375' Lime and Shale
3455' Shale
3520' Shale and Shells
3816' Lime
3862' Shale
3877' Lime T.D.

GEOLOGIST TOPS

Lansing K.C. ----- 3485'
Small show oil from 3622'-25'
Conglomerate ----- 3792'
Viola ----- 3864'
Fair porosity and slight show
oil from 3864' to 77'
360' of salt water in Drill
stem test with Packer at 3864'
Rainbow of oil in water.

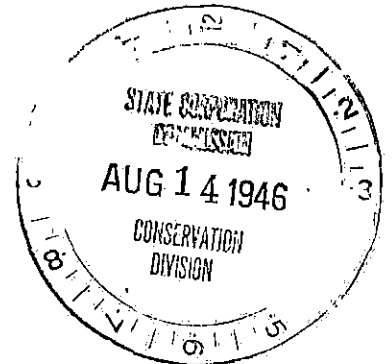

I HEREBY CERTIFY THE ABOVE RECORD IS A TRUE AND CORRECT RECORD OF THE
DRILLERS LOG ON THIS WELL.

SIGNED *E. E. Duncan*

SUBSCRIBED AND SWORN TO BEFORE ME THIS 14 DAY OF Aug - 1946
MY COMMISSION EXPIRES Aug 4 - 1950

O. Casey
NOTARY PUBLIC

FILED IN 15 24 12W
66 38