


STATE OF KANSAS
STATE CORPORATION COMMISSION

WELL PLUGGING RECORD

Give All Information Completely
Make Required Affidavit
Mail or Deliver Report to:
Conservation Division
State Corporation Commission
800 Bitting Building
Wichita, Kansas

Stafford County. Sec. 15 Twp. 24S Rge. 12 (W)

Location as "NE/CNW $\frac{1}{4}$ SW $\frac{1}{4}$ " or footage from lines N/2, SW/4, SE/4
Lease Owner Stanolind Oil and Gas Company
Lease Name R. Charles "B" Well No. 4
Office Address Box 1654, Oklahoma City, Oklahoma
Character of Well (completed as Oil, Gas or Dry Hole) Oil
Date well completed 5-9 19 41
Application for plugging filed 6-5 19 50
Application for plugging approved 6-7 19 50
Plugging commenced 6-5 19 50
Plugging completed 6-8 19 50
Reason for abandonment of well or producing formation Depleted

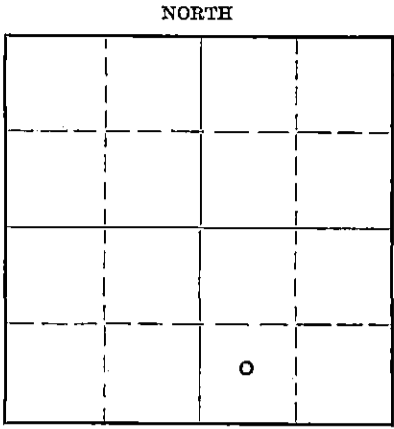

Locate well correctly on above Section Plat

If a producing well is abandoned, date of last production April 19 50
Was permission obtained from the Conservation Division or its agents before plugging was commenced? Yes

Name of Conservation Agent who supervised plugging of this well C. D. Stough
Producing formation Arbuckle Depth to top 394.5 Bottom 396.4 Total Depth of Well 396.4 Feet
Show depth and thickness of all water, oil and gas formations.

OIL, GAS OR WATER RECORDS

CASING RECORD

| Formation | Content | From | To | Size | Put In | Pulled Out |
|-----------|---------|-------|-------|-------|--------|------------|
| Arbuckle | Oil | 394.5 | 396.4 | 8 5/8 | 256 | None |
| | | | | 5 1/2 | 3972 | 1926 |
| | | | | | | |
| | | | | | | |
| | | | | | | |
| | | | | | | |
| | | | | | | |
| | | | | | | |
| | | | | | | |
| | | | | | | |

Describe in detail the manner in which the well was plugged, indicating where the mud fluid was placed and the method or methods used in introducing it into the hole. If cement or other plugs were used, state the character of same and depth placed, from...feet to...feet for each plug set.

Crushed Rock 3496' - 3475'
6 Sx Cement 3475' - 3440'
Hvy. Mud 3440' - 260'
Crushed Rock 260' - 253'
15 Sx Cement 253' - 200'
Hvy. Mud 200' - 42'
10 Sx Cement 42' - 4'
Cellar 4' - 0'

(If additional description is necessary, use BACK of this sheet)

Correspondence regarding this well should be addressed to G. A. Younie
Address Box 7, Ellinwood, Kansas

STATE OF Kansas, COUNTY OF Barton, ss.
G. A. Younie (employee of owner) or (owner or operator) of the above-described well,


being first duly sworn on oath, says: That I have knowledge of the facts, statements, and matters herein contained and the log of the above-described well as filed and that the same are true and correct. So help me God.

(Signature) *G. Younie* Field Superintendent
Box 7, Ellinwood, Kansas (Address)

SUBSCRIBED AND SWORN TO before me this 27th day of June, 19 50

A. J. H. Rader
Notary Public.

My commission expires November 14, 1953

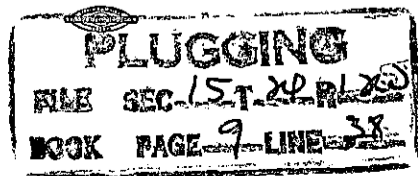

JUN 28 1950
COMMISSIONER
KANSAS
6-28-50

FORMATION RECORD

DESCRIBE EACH FORMATION DRILLED. INDICATE THICKNESS, CONTENT AND WHETHER DRY, OR OIL, GAS, OR WATER BEARING.

| FORMATION | TOP | BOTTOM | FORMATION | TOP | BOTTOM |
|-----------------------|------|--------|-----------|-----|--------|
| cellar | 0 | 6 | | | |
| surface sand | 6 | 192 | | | |
| red bed and shale | 192 | 265 | | | |
| red bed and sand | 265 | 465 | | | |
| red rock | 465 | 656 | | | |
| anhydrite | 656 | 690 | | | |
| shale | 690 | 845 | | | |
| shale and shells | 845 | 1217 | | | |
| shale | 1217 | 1550 | | | |
| shale and lime shells | 1550 | 1700 | | | |
| broken lime | 1700 | 1798 | | | |
| lime | 1798 | 1874 | | | |
| broken lime | 1874 | 1935 | | | |
| sandy shale | 1935 | 1960 | | | |
| lime | 1960 | 2095 | | | |
| shale | 2095 | 2121 | | | |
| broken lime | 2121 | 2269 | | | |
| lime | 2269 | 2300 | | | |
| shale | 2300 | 2350 | | | |
| lime | 2350 | 2360 | | | |
| shale | 2360 | 2485 | | | |
| shale and shells | 2485 | 2680 | | | |
| shale | 2680 | 2715 | | | |
| lime | 2715 | 2832 | | | |
| broken lime and shale | 2832 | 2932 | | | |
| shale and shells | 2932 | 2960 | | | |
| lime | 2960 | 3230 | | | |
| broken lime | 3230 | 3272 | | | |
| lime | 3272 | 3312 | | | |
| shale and shells | 3312 | 3392 | | | |
| shale | 3392 | 3468 | | | |
| lime | 3468 | 3537 | | | |
| broken lime | 3537 | 3544 | | | |
| lime | 3544 | 3578 | | | |
| broken lime | 3578 | 3609 | | | |
| lime | 3609 | 3746 | | | |
| lime and chert | 3746 | 3799 | | | |
| shale and chert | 3799 | 3820 | | | |
| lime and chert | 3820 | 3828 | | | |
| shale, lime and chert | 3828 | 3856 | | | |
| lime | 3856 | 3898 | | | |
| shale | 3898 | 3944 | | | |
| dolomite | 3944 | 3964 | | | |
| <u>Total Depth</u> | 3964 | | | | |

PLUGGING
 FILE SEC 15-T-24 R 12
 BOOK PAGE 9 LINE 58