


STATE OF KANSAS
STATE CORPORATION COMMISSION.

WELL PLUGGING RECORD

Give All Information Completely
Make Required Affidavit
Mail or Deliver Report to
Conservation Division
State Corporation Comm.
245 North Water
Wichita, KS 67202

Stafford County. Sec. 13 Twp. 24 Rge. 12 E/W
Location as "NE/CNW $\frac{1}{4}$ SW $\frac{1}{4}$ " or footage from lines 990 from south line
500 from east line
Lease Owner Schneidangel Co.
Lease Name Jespina Well No. 1
Office Address Tribune Kans.
Character of Well (Completed as Oil, Gas or Dry Hole) oil

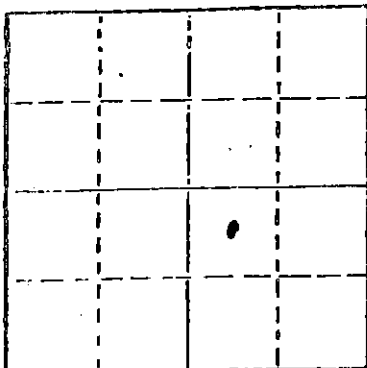

Locate well correctly on above
Section 71st

Date Well completed _____ 19____
Application for plugging filed _____ 1984
Application for plugging approved _____ 1984
Plugging commenced _____ 1984
Plugging completed July 29 1984
Reason for abandonment of well or producing formation no oil
all water
If a producing well is abandoned, date of last production _____ 1982

Was permission obtained from the Conservation Division or its agents before plugging was commenced? yes

Name of Conservation Agent who supervised plugging of this well Mitch
Producing formation unbrack plug 1/2 in Depth to top _____ Bottom _____ Total depth of Well 3961
Show depth and thickness of all water, oil and gas formations. No Records

OIL, GAS OR WATER RECORDS

CASING RECORD

FORMATION	CONTENT	FROM	TO	SIZE	PUT IN	PULLED OUT
	<u>Surface casing</u>	<u>274</u>	<u>10 3/4</u>			
				<u>7 inch</u>	<u>3958</u>	<u>None</u>

Describe in detail the manner in which the well was plugged, indicating where the mud fluid was placed and the method or methods used in introducing it into the hold. If cement or other plugs were used, state the character of same and depth placed, from _____ feet to _____ feet for each plug set.

Spaced 250, pack cement down casing and 20
feet down surface the 29th let set over night, 30th spaced 250
feet down casing, Circulated to surface, let set 3 days, filled surface
and casing with 1 spec Regal Bridge Cement, cut casing and surface
off 5 feet below ground level,

(If additional description is necessary, use BACK of this sheet)

Name of Plugging Contractor Halliburton

STATE OF Kansas COUNTY OF Stafford, ss.
Donald Fisher (employee of owner) or (owner or operator)
of the above-described well, being first duly sworn on oath, says: That I have knowledge of the facts, statements, and matters herein contained and the log of the above-described well as filed and that the same are true and correct. So help me God.

(Signature) Donald Fisher
R.R. 1 Steward Kans. 67577
(Address)

SUBSCRIBED AND SWORN TO before me this 5th day of September, 1984

Wanda F. Vorker
Notary Public.

My commission expires 11-2-85

RECEIVED
STATE CORPORATION COMMISSION
9-6-84
SEP 06 1984

WANDA F. VORKER
NOTARY PUBLIC
State of Kansas
My Appointment Expires 11-2-85

CONSERVATION DIVISION
Wichita, Kansas