


STATE OF KANSAS
STATE CORPORATION COMMISSION

Give All Information Completely
Make Required Affidavit
Mail or Deliver Report to:
Conservation Division
State Corporation Commission
800 Bittling Building
Wichita, Kansas

WELL PLUGGING RECORD

NORTH

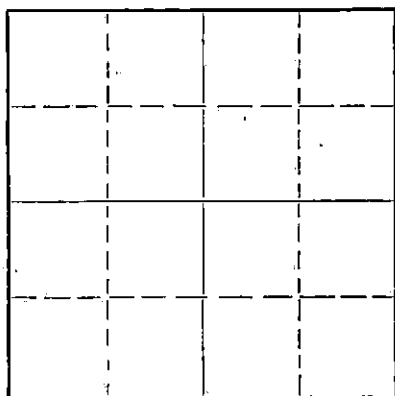

Locate well correctly on above
Section Plat

Stafford County, Sec. 16 Twp. 24 Rge. 12 (E) W (W)

Location as "NE/CNW/SW" or footage from lines SW SW NW

Lease Owner Anschutz Drilling Company, Inc.

Lease Name Galloway Well No. 1

Office Address 709 Union Nat'l Bk Bldg., Wichita, Ks.

Character of Well (completed as Oil, Gas or Dry Hole) Dry Hole

Date well completed 8-17-1952

Application for plugging filed 8-17-1952

Application for plugging approved 8-17-1952

Plugging commenced 8-17-1952

Plugging completed 8-17-1952

Reason for abandonment of well or producing formation Dry

If a producing well is abandoned, date of last production 19

Was permission obtained from the Conservation Division or its agents before plugging was commenced? Yes

Name of Conservation Agent who supervised plugging of this well C. D. Stough

Producing formation Depth to top Bottom Total Depth of Well 4080 Feet

Show depth and thickness of all water, oil and gas formations.

OIL, GAS OR WATER RECORDS

CASING RECORD

FORMATION	CONTENT	FROM	TO	SIZE	PUT IN	PULLED OUT
				8-5/8"	271	

Describe in detail the manner in which the well was plugged, indicating where the mud fluid was placed and the method or methods used in introducing it into the hole. If cement or other plugs were used, state the character of same and depth placed, from feet to feet for each plug set.

Top plug set at 35' with 10 sacks cement

Bottom plug set at 270' with 20 sacks cement

RECEIVED
STATE CORPORATION COMMISSION
AUG 30 1952

CONGREGATION DIVISION

Recd
8-30-52

Name of Plugging Contractor Anschutz Drilling Company, Inc.

Address 709 Union Nat'l Bk Bldg., Wichita, Kansas

STATE OF KANSAS, COUNTY OF SEDGWICK, ss.

Leon L. Mehler

(employee of owner) or (owner or operator) of the above-described

well, being first duly sworn on oath, says: That I have knowledge of the facts, statements, and matters herein contained and the log of the above-described well as filed and that the same are true and correct. So help me God.

(Signature)

709 Union Nat'l Bk Bldg., Wichita, Ks.

(Address)

SUBSCRIBED AND SWORN TO before me this 29th day of August, 1952

My commission expires May 2, 1956

Notary Public.

24-2675-5 2-52-20M

PLUGGING
FILE SEC 16 T 24 R 12
BOOK PAGE 38 LINE 3

DRILLER'S LOG

Anschutz Drilling Company, Inc.
#1 Galloway
SW SW NW - 16-24S-12W
Stafford County, Kansas

<u>FROM</u>	<u>TO</u>	
0	210	Sand
210	690	Red bed & shale
690	720	Anhydrite
720	1185	Shale & shells
1185	1235	Shale & salt
1235	1540	Shale & shells
1540	1850	Lime
1850	1985	Sandy lime
1985	2125	Lime
2125	2210	Shale & lime
2210	2445	Lime
2445	2595	Lime broken
2595	2755	Lime & shale
2755	2850	Lime
2850	2980	Lime broken
2980	3120	Lime & shale
3120	3350	Lime
3350	3370	Lime "sandy"
3370	3502	Shale
3502	3863	Lime
3863	3888	Shale & lime
3888	3890	Viola chert
3890	3915	Viola dolomite
3915	3946	Chert
3946	3973	Viola dolomite
3973	3997	Viola
3997	4003	Viola lime
4003	4049	Simpson
4049	4066	Simpson shale
4066	4080	Arbuckle dolomite
	4080	TOTAL DEPTH
		D&A

COMMENCED: 8-2-52
COMPLETED: 8-17-52

CASING RECORD

Set 8-5/8" surface casing at 271 feet with 175 sacks cement.

ELEVATION: 1884 RB

TOPS

Heebner 3320
Brown Lime 3474
Lansing 3501
Conglomerate 3823
Viola Chert 3888
Simpson 4004
Arbuckle 4066

STATE OF KANSAS)
COUNTY OF SEDGWICK) SS

I hereby affirm that the foregoing is a true and correct copy of the log of Anschutz Drilling Company, Inc. #1 Galloway located SW SW NW of Section 16-24S-12W, Stafford County, Kansas.

STATE OF KANSAS
COUNTY OF SEDGWICK

ANSCHUTZ DRILLING COMPANY, INC.

BY:

Leon L. Mehler
Leon L. Mehler

Subscribed and sworn to before me this 29th day of August, 1952.

Jacqueline L. Kansas
Notary Public

My commission expires: May 2, 1956

