

STATE OF KANSAS
STATE CORPORATION COMMISSION

Form CP-4


Give All Information Completely
Make Required Affidavit
Mail or Deliver Report to:
Conservation Division
State Corporation Commission
212 No. Market
Wichita, Kansas

WELL PLUGGING RECORD

STAFFORD County. Sec. 17 Twp. 24 Rge. 12 (E) W (W)

Location as "NE/CNWKSWK" or footage from lines. NW NW NE
Lease Owner MORGENSTERN OIL OPERATIONS
Lease Name BRENSING Well No. 1
Office Address 511 Union National Building, Wichita, Kansas 67202
Character of Well (completed as Oil, Gas or Dry Hole) Oil Well
Date well completed September 12 19 57
Application for plugging filed 19
Application for plugging approved June 5, 19 69
Plugging commenced June 6, 19 69
Plugging completed June 9, 19 69
Reason for abandonment of well or producing formation

NORTH

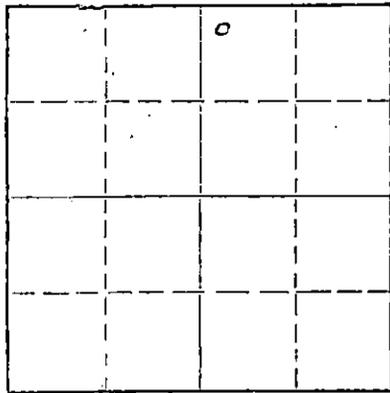

Locate well correctly on above
Section Plat

If a producing well is abandoned, date of last production 19
Was permission obtained from the Conservation Division or its agents before plugging was commenced? Yes

Name of Conservation Agent who supervised plugging of this well Ralph J. Warren
Producing formation Viola Lime Depth to top Bottom Total Depth of Well 3,877 Feet
Show depth and thickness of all water, oil and gas formations.

OIL, GAS OR WATER RECORDS

CASING RECORD

FORMATION	CONTENT	FROM	TO	SIZE	PUT IN	PULLED OUT
				8 5/8"	366.57'	None
				5 1/2"	3,873.	3,219.07'

Describe in detail the manner in which the well was plugged, indicating where the mud fluid was placed and the method or methods used in introducing it into the hole. If cement or other plugs were used, state the character of same and depth placed, from feet to feet for each plug set.

Cleaned out cellar & rigged up. Filled with sand from 3877' to 3870'. Run five sacks of cement from 3870' to 3840'. Shot at 3416', 3319', 3214' and started pipe. Pulled pipe. Set plug at 270'. Rock from 270' to 260'. Run 25 sacks of cement from 260' to 185'. Mudded from 185' to 40'. Rock from 40' to 30'. Run 10 sacks of cement from 30' to base of cellar.

RECEIVED
STATE CORPORATION COMMISSION
7-11-69
JUL 11 1969
CONSERVATION DIVISION
Wichita, Kansas

(If additional description is necessary, use BACK of this sheet)
Name of Plugging Contractor GLENN & SMITH PIPE PULLING CO.
Address P. O. Box 156, Ellinwood, Kansas 67526

STATE OF KANSAS, COUNTY OF SEDGWICK, ss.
Arthur Morgenstern (owner-operator) (employee of owner) or (owner or operator) of the above-described

well, being first duly sworn to before me, says: That I have knowledge of the facts, statements, and matters herein contained and the log of the above-described well as filed and that the same are true and correct. So help me God.

(Signature) Arthur Morgenstern
511 Union National Building, Wichita, Kansas
(Address)

Subscribed and Sworn to before me this 10th day of July, 19 69

February 18, 1972 Arlyen M. Yerton, Notary Public.



WELL LOG BUREAU—KANSAS GEOLOGICAL SOCIETY
508 East Murdock, Wichita, Kansas

COPY


Company- W.J. COPPINGER
Farm- Breensing No. 1

SEC. 17 T. 24 R. 12W
NW NW NE

Total Depth. 3877'
Comm. 9-2-57 Comp. 9-12-57
Shot or Treated.

County Stafford
KANSAS

Contractor. Rec & Morris Drilg. Co.
Issued. 11-30-57

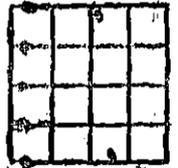

CASING:
8 5/8" 366.57' w/250 sx cem
5 1/2" 3873' 2/75 sx cem

Elevation. 1890' RM

Production. 139 BOPD

Figures indicate Bottom of Formations.

shale (surface hole)	370
shale-red beds	895
shale-shells	1660
lime-shale	3200
lime	3255
brkn lime	3305
lime	3350
lime-shale	3530
lime	3860
shale-lime	3872
lime (Viola)	3877
Total Depth	

TOPS: Scout	
Heebnor	3327
Brown Lime	3477
Lansing	3506
Viola	3872

RECEIVED
STATE CORPORATION COMMISSION
JUN 5 1969
CONSERVATION DIVISION
Wichita, Kansas