

STATE OF KANSAS
STATE CORPORATION COMMISSION

WELL PLUGGING RECORD

OR


FORMATION PLUGGING RECORD

Strike out upper line
when reporting plug-
ging off formations.

Give All Information Completely
Make Required Affidavit
Mail or Deliver Report to:
Conservation Division
State Corporation Commission
800 Bitting Building
Wichita, Kansas

Stafford County, Sec. 17, Twp. 24, Rge. (E) 12 (W)
Location as "NE 1/4 NW 1/4 SW 1/4" or footage from lines NW/4 NW/4 NW/4
Lease Owner Musgrove Petroleum Corporation
Lease Name McMillan Well No. 1
Office Address 407 K.F.H. Building, Wichita 2, Kansas
Character of Well (completed as Oil, Gas or Dry Hole) Dry Hole
Date well completed 10-6 1948
Application for plugging filed 10-6 1948
Application for plugging approved (Via Telephone) 10-6 1948
Plugging commenced 10-6 1948
Plugging completed 10-7 1948
Reason for abandonment of well or producing formation Dry Hole

NORTH

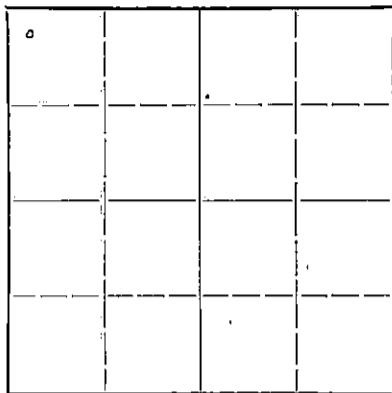

Locate well correctly on above
Section Plat

If a producing well is abandoned, date of last production 19
Was permission obtained from the Conservation Division or its agents before plugging was com-
menced? Agent

Name of Conservation Agent who supervised plugging of this well C. D. Stough
Producing formation Depth to top Bottom Total Depth of Well 415 Feet
Show depth and thickness of all water, oil and gas formations.

OIL, GAS OR WATER RECORDS

CASING RECORD

Formation	Content	From	To	Size	Put In	Pulled Out

Describe in detail the manner in which the well was plugged, indicating where the mud fluid was placed and the method or methods used in introducing it into the hold. If cement or other plugs were used, state the character of same and depth placed, from feet to feet for each plug set.

Hole filled with heavy mud to 380'
Set wooden plug at 380'
Filled with 15 sacks of cement.
Filled with heavy mud from 380' to 25'
Filled with 10 sacks of cement.

007 9 - 1948
Recd 10-9-48

(If additional description is necessary, use BACK of this sheet)

Correspondence regarding this well should be addressed to Musgrove Petroleum Corporation
Address 407 K.F.H. Building
Wichita 2, Kansas

STATE OF KANSAS, COUNTY OF SEDGWICK, ss.
P. C. Musgrove (owner or operator) of the above-described well,
being first duly sworn on oath, says: That I have knowledge of the facts, statements, and matters herein contained and the log of the above-described well as filed and that the same are true and correct. So help me God.

(Signature) P. C. Musgrove


407 K.F.H. Bldg., Wichita 2, Kansas
(Address)

SUBSCRIBED AND SWORN to before me this 8th day of October, 1948

Madeline J. Irrel
Notary Public.

My commission expires December 5, 1951

22-287 7-47-10M

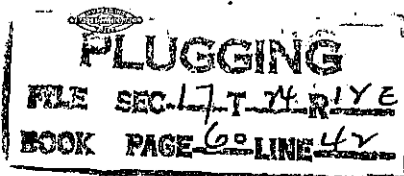

CONTRACTOR'S WELL LOG

Operator Musgrove Petroleum Corporation, Inc. Farm Name McMillan #1
 Location NW⁴/₄ NW⁴/₄ NW⁴/₄ Sec. 17, Twp. 24 S, Rge. 12 W.
 Pool Name Wildcat County Stafford State Kansas
 Commencement Date September 20, 1948 Completion Date October 6, 1948

LOG OF WELL

ELEVATION 1886' DF

All measurements from the top of rotary bushing.

DEPTH		FORMATION	DEVIATION	REMARKS:
FROM	TO		FROM VERTICAL	
0	255	Sand-Shale		
255	385	Sand-Shale		
550	697	Red Bed-Shale		
697	719	Anhydrite		
719	1145	Shale-Red Bed	1000' - 0°	
1145	1400	Shale-Shells		
1400	1640	Shale-Shells	1500' - 0°	
1640	1690	Shale-Lime		
1690	1875	Lime-Shale		
1875	1940	Lime		
1940	2140	Lime-Shale	2000' - 0°	
2140	2245	Lime-Shale		
2245	2365	Shale-Shells		
2365	2490	Lime-Shale		
2490	2620	Shale-Lime		
2620	2725	Lime-Shale	2500' - 0°	
2725	2835	Lime-Shale		
2835	2925	Lime-Shale		
2925	3045	Lime-Shale		
3045	3170	Shale-Lime		
3170	3245	Lime-Shale		
3245	3290	Lime-Shale		
3290	3420	Lime-Shale		
3420	3490	Lime-Shale		
3490	3550	Lime	3500' - 0°	
3550	3558	Lime		
3558	3582	Lime-Shale		
3582	3610	Lime		
3610	3650	Lime		
3650	3680	Lime-Shale		
3680	3725	Lime		
3725	3770	Lime		
3770	3820	Lime		
3820	3850	Shale-Lime		
3850	3882	Conglomerate		
3882	3902	Shale-Lime		
3902	3911	Lime		
3911	3935	Cherty Lime		
3935	3954	Lime-Shale		
3954	3980	Lime		
3980	4020	Lime		
4020	4060	Lime		
4060	4100	Shale-Lime		
4100	4115	Lime		

OCT 9 - 1948

CASING LEFT IN HOLE AFTER COMPLETION

Set 385.27' 8-5/8" OD Surface Casing.

STATE OF KANSAS, COUNTY OF SEDGWICK, SS.

The undersigned certifies that to the best of his knowledge and belief the above facts are true and correct.

C-G DRILLING COMPANY, Inc.

By J. C. Cook
President

Subscribed and sworn to before me this 8th day of October, 1948.

Vicky Fritz
Notary Public

My commission expires: June 25, 1951

PLUGGING
 FILE SEC-17-T-74-R-112
 BOOK PAGE-60-LINE-42