


STATE OF KANSAS  
STATE CORPORATION COMMISSION

Give All Information Completely  
Make Required Affidavit  
Mail or Deliver Report to:  
Conservation Division  
State Corporation Commission  
800 Bittling Building  
Wichita, Kansas

WELL PLUGGING RECORD

Stafford County, Sec. 31 Twp. 24S Rge. 11 (E) (W)

Location as "NE/CNW/SW" or footage from lines C-NW-SW-NE  
Lease Owner Cooperative Refinery Ass'n. & Rex Morris Drlg. Co.  
Lease Name Irvine "C" Well No. 1  
Office Address Box 765 Great Bend, Kansas  
Character of Well (completed as Oil, Gas or Dry Hole) Dry hole  
Date well completed November 21 19 55  
Application for plugging filed November 21 19 55  
Application for plugging approved November 22 19 55  
Plugging commenced November 22 19 55  
Plugging completed November 22 19 55  
Reason for abandonment of well or producing formation \_\_\_\_\_  
Dry hole

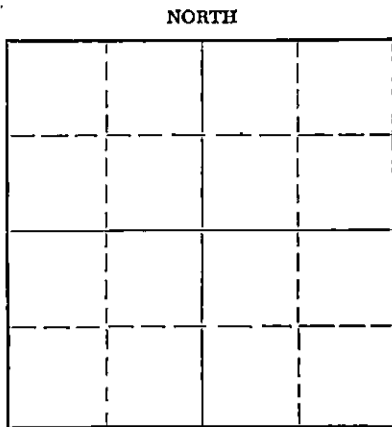

Locate well correctly on above  
Section Plat

If a producing well is abandoned, date of last production \_\_\_\_\_ 19 \_\_\_\_\_  
Was permission obtained from the Conservation Division or its agents before plugging was commenced? Yes

Name of Conservation Agent who supervised plugging of this well Warren Horner  
Producing formation \_\_\_\_\_ Depth to top \_\_\_\_\_ Bottom \_\_\_\_\_ Total Depth of Well 4109 Feet  
Show depth and thickness of all water, oil and gas formations.

OIL, GAS OR WATER RECORDS

CASING RECORD

FORMATION	CONTENT	FROM	TO	SIZE	PUT IN	PULLED OUT
				8 5/8	305	-0-

Describe in detail the manner in which the well was plugged, indicating where the mud fluid was placed and the method or methods used in introducing it into the hole. If cement or other plugs were used, state the character of same and depth placed, from \_\_\_\_\_ feet to \_\_\_\_\_ feet for each plug set.

Hole filled with heavy mud to 300'. First plug set at 300', 1/3 sacks hulls  
20 sacks cement through drill pipe, heavy mud from 300 to 35'. Top plug set at  
35', 1/3 sacks hulls, 10 sacks cement to ground level.

(If additional description is necessary, use BACK of this sheet)  
Name of Plugging Contractor Company Rig #5  
Address Box 765 Great Bend, Kansas

STATE OF KANSAS, COUNTY OF BARTON, ss.  
P. H. Jackson (employee of owner) or (owner or operator) of the above-described well, being first duly sworn on oath, says: That I have knowledge of the facts, statements, and matters herein contained and the log of the above-described well as filed and that the same are true and correct. So help me God.

(Signature) P. H. Jackson  
Box 765 Great Bend, Kansas  
(Address)

SUBSCRIBED AND SWORN to before me this 23 day of November 19 55

Donald E. Hunt  
Notary Public.

My commission expires August 17, 1957

24-7368-S 3-53-20M STATE CORP COMMISSION

PLUGGING  
FILE SEC 21 T 24 R 11 W  
BOOK PAGE 19 LINE 19

NOV 25 1955  
11-25-55  
CONSERVATION DIVISION  
Wichita, Kansas

DRILLERS LOG

Irvine C #1

Loc: C-NW-SW-NE  
 Sec: 31-24S-11W  
 Stafford County, Kansas  
 Operator: Cooperative Refinery Ass'n.  
 Contractor: Company Rig #5

Elevation: 1834 D.F.  
 Casing: 8 5/8 @ 305' with 200 sacks  
 posmix, 2 C.C.  
 Comm: 11-8-55 Comp: 11-21-55  
 Total Depth: 4109

<u>From</u>	<u>To</u>	<u>Formation</u>
0	305	Surface hole
305	900	Red bed, shale sand
900	1520	Shale and shells
1520	1700	Shale and lime
1700	1860	Shale and shells
1860	2615	Shale and lime
2615	2790	Shale
2790	3135	Shale and lime
3135	3200	Lime
3200	3240	Lime and shale
3240	3380	Shale
3380	3545	Lime and shale
3545	3780	Lime
3780	3875	Lime and shale
3875	3907	Lime
3907	3935	Cherty shale and lime
3935	3962	Lime
3962	3990	Chert and lime
3990	4015	Lime, shale and chert
4015	4040	Lime
4040	4069	Sand, shale and lime
4069	4109	Lime
4109		R.T.D.

(STATE OF KANSAS )

(COUNTY OF BARTON)

I hereby certify that the above is a true and correct copy of the log on the Irvine "C" #1 well, located C-NW-SW-NE of Section 31-24S-11W, Stafford County, Kansas.

Subscribed and sworn to before me this 23 day of November 1955

John H. Nation

Donald E. Hunt

My commission expires: August 17, 1957

RECEIVED  
 NOV 25 1955  
 COMMISSION DIVISION  
 Topeka, Kansas

PLUGGING  
 FILE SEC 31-24-11W  
 CASE PAGE 19 LINE 19