


STATE OF KANSAS  
STATE CORPORATION COMMISSION

Give All Information Completely  
Make Required Affidavit  
Mail or Deliver Report to:  
Conservation Division  
State Corporation Commission  
211 No. Broadway  
Wichita, Kansas

WELL PLUGGING RECORD

NORTH

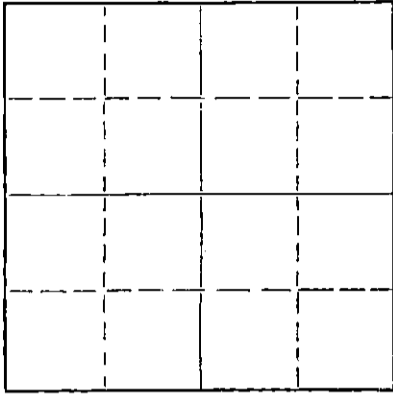

Locate well correctly on above  
Section Plat

Stafford County, Sec. 11 Twp. 24 Rge. (E) 12 (W)  
Location as "NE/CNW/SW" or footage from lines NW - SW - NE  
Lease Owner Herman George Kaiser  
Lease Name Richardson Well No. 3  
Office Address Ellinwood, Kansas  
Character of Well (completed as Oil, Gas or Dry Hole)  
Date well completed 19  
Application for plugging filed 19  
Application for plugging approved 19  
Plugging commenced June 5 19 58  
Plugging completed June 12 19 58  
Reason for abandonment of well or producing formation

If a producing well is abandoned, date of last production 19  
Was permission obtained from the Conservation Division or its agents before plugging was commenced? Yes

Name of Conservation Agent who supervised plugging of this well Frank Brodfoot  
Producing formation Depth to top Bottom Total Depth of Well Feet  
Show depth and thickness of all water, oil and gas formations.

OIL, GAS OR WATER RECORDS

CASING RECORD

FORMATION	CONTENT	FROM	TO	SIZE	PUT IN	PULLED OUT
				8 5/8	209	None
				5 1/2	3815	3051.84

Describe in detail the manner in which the well was plugged, indicating where the mud fluid was placed and the method or methods used in introducing it into the hole. If cement or other plugs were used, state the character of same and depth placed, from feet to feet for each plug set.

Sanded to 3800' - dumped 5 sks cement - squeezed well with 20 sks mud and 75 sks cement - checked hole to see where top of cement was found top of cement at 35' - finished filling casing with cement.

RECEIVED  
STATE CORPORATION COMMISSION

JUN 19 1958  
6-19-58  
CONSERVATION DIVISION  
Wichita, Kansas

(If additional description is necessary, use BACK of this sheet)  
Name of Plugging Contractor R & D Casing Pulling Company License # 236  
Address Box 569 Ellinwood, Kansas

STATE OF Kansas, COUNTY OF Barton, ss.  
I, W. J. Hall (employee of owner) or (owner or operator) of the above-described well, being first duly sworn on oath, says: That I have knowledge of the facts, statements, and matters herein contained and the log of the above-described well as filed and that the same are true and correct. So help me God  
(Signature) *W. J. Hall*

SUBSCRIBED AND SWORN TO before me this 16 day of June, 19 58  
*Delmer L. Postier*  
Notary Public.

My commission expires

PLUGGING  
FILE SEC. 11, T. 24, R. 12W  
BOOK PAGE 103 LINE 10

L O G

Company: Armer Drilling Company, Inc.  
Contractor: Judy Drilling Company, Inc.  
Drilling commenced: 3/18/50  
Drilling completed: 4/2/50  
Elevation Est. 1858 D. F.  
Gr. 1856

Farm: Richardson - well #3  
Location: NW SW NE Sec. 11-24S-12W,  
Stafford County, Kansas

Casing record: 8-5/8" surface @ 209'  
cemented w/200 sacks  
5 1/2" @ 3815 cemented  
w/125 sacks

(figures below indicate bottoms)

Surface clay	30
Sand	40
Sand & shale	150
Red bed, shale & shells	209
Shale & shells	325
Shale, red bed	630
Anhydrite	650
Shale, lime shells	920
Shale & shells	1350
Shale & lime	1625
Lime, broken	1730
Sandy lime	1830
Lime	2025
Lime & shale	2280
Shale	2385
Lime & shale	2850
Shale	2950
Lime & shale	3070
Lime	3235
Shale & lime	3405
Shale	3455
Lime	3740
Lime & shale	3770
Lime	3821
Total depth - rotary	3821

Formation tops:

Heebner	3259
Brown lime	3410
Lansing-Kansas City	3438
Viola	3814

I hereby certify that this is a true and correct log of the above described well as shown by the drilling reports.

PLUGGING	
FILE	SEC 11-24-12W
BOOK	PAGE 103 LINE 10

JUDY DRILLING COMPANY, INC.

RECEIVED  
STATE CORPORATION COMMISSION

By L. C. Sponenberg  
L. C. Sponenberg

STATE OF KANSAS ) SS  
COUNTY OF SEDGWICK }

MAY 27 1958

CONSERVATION DIVISION  
Wichita, Kansas

Subscribed and sworn to before me, a notary public, in and for said County and State this 6th day of April, 1950.

Harold Dacton  
Notary Public

My commission expires Sept. 17, 1951