


STATE OF KANSAS
STATE CORPORATION COMMISSION

Give All Information Completely
Make Required Affidavit
Mail or Deliver Report to:
Conservation Division
State Corporation Commission
1 No. Broadway
Wichita, Kansas

WELL PLUGGING RECORD

NORTH

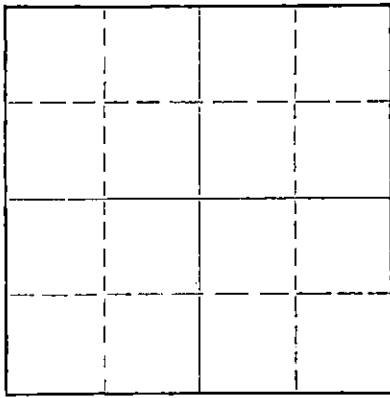

Locate well correctly on above
Section Plat

Stafford County, Sec. 9 Twp. 24S Rge. (E) 12 (W)
Location as "NE/CNW/SW" or footage from lines app. C NW NE
Lease Owner O. A. Sutton
Lease Name Blackburn Well No. 1
Office Address 407 Insurance Building, Wichita, Kansas
Character of Well (completed as Oil, Gas or Dry Hole) Dry Hole
Date well completed January 5 1965
Application for plugging filed January 5 1965
Application for plugging approved January 5 1965
Plugging commenced January 5 1965
Plugging completed January 5 1965
Reason for abandonment of well or producing formation

If a producing well is abandoned, date of last production 19
Was permission obtained from the Conservation Division or its agents before plugging was commenced? Yes

Name of Conservation Agent who supervised plugging of this well Archie Elving
Producing formation Depth to top Bottom Total Depth of Well 3905 Feet
Show depth and thickness of all water, oil and gas formations.

OIL, GAS OR WATER RECORDS

CASING RECORD

FORMATION	CONTENT	FROM	TO	SIZE	PUT IN	PULLED OUT
				8-5/8"	242	

Describe in detail the manner in which the well was plugged, indicating where the mud fluid was placed and the method or methods used in introducing it into the hole. If cement or other plugs were used, state the character of same and depth placed, from feet to feet for each plug set.

Set 1st plug at 225' with 25 sacks through drill pipe. Filled with heavy mud to 40', set 2nd plug with 1/2 sack hulls and 10 sacks cement. Bridge rat hole plug.

RECEIVED
STATE CORPORATION COMMISSION

JAN 11 1965
1-11-65

CONSERVATION DIVISION
Wichita, Kansas

(If additional description is necessary, use BACK of this sheet)
Name of Plugging Contractor Gabbert-Jones Inc.
Address 407 Insurance Building, Wichita, Kansas

STATE OF KANSAS, COUNTY OF SEDGWICK, ss.
W. H. Petersen (employee of owner) or (owner) of the above-described well, being first duly sworn on oath, says: That I have knowledge of the facts, statements, and matters herein contained and the log of the above-described well as filed and that the same are true and correct. So help me God.

(Signature) W. H. Petersen
407 Insurance Building, Wichita, Kansas
(Address)

SUBSCRIBED AND SWORN TO before me this 11th day of January, 1965

My commission expires June 28, 1966.

Jean S. Taylor
Jean S. Taylor

Notary Public.

GABBERT-JONES INC.
WICHITA, KANSAS
DRILLERS WELL LOG

RECEIVED
STATE CORPORATION COMMISSION

JAN 11 1965

CONSERVATION DIVISION
Wichita, Kansas

BLACKBURN #1
C NW NE SECTION 9-24S-12W
STAFFORD COUNTY, KANSAS

COMMENCED: DECEMBER 23, 1964
COMPLETED: JANUARY 5, 1965

OPERATOR-O. A. SUTTON

DEPTH		FORMATION	REMARKS
FROM	To		
0	242	SHALE	RAN 7 JOINTS 8-5/8" CASING, SET @ 242' w/240 SACKS CEMENT
242	685	SAND	
685	718	ANHYDRITE	
718	1082	SHALE	
1082	1960	SHALE & SHELLS	
1960	2675	LIME & SHALE	
2675	2780	SHALE & SHELLS	
2780	3525	LIME & SHALE	
3525	3720	LIME	
3720	3772	LIME & SHALE	
3772	3805	LIME	
3805	3898	LIME & SHALE	
3898	3905	LIME & CHERT	
3905	TD		DRY & ABANDONED

I, E. E. HALL, CERTIFY THIS IS A CORRECT COPY OF THE DRILLER'S LOG FOR THE WELL
DRILLED IN THE C NW NE SECTION 9-24S-12W, STAFFORD COUNTY, KANSAS, TO THE BEST OF MY
KNOWLEDGE AND BELIEF.

E. E. Hall
E. E. HALL

STATE OF KANSAS)
COUNTY OF SEDGWICK) SS

BEFORE ME, THE UNDERSIGNED, A NOTARY PUBLIC WITHIN AND FOR SAID COUNTY AND STATE,
ON THIS 7TH DAY OF JANUARY, 1965, PERSONALLY APPEARED E. E. HALL, TO ME PERSONALLY KNOWN TO
BE THE IDENTICAL PERSON WHO EXECUTED THE WITHIN AND FOREGOING INSTRUMENT AND ACKNOWLEDGED TO
ME THAT HE EXECUTED THE SAME AS HIS FREE AND VOLUNTARY ACT AND DEED FOR THE USES AND
PURPOSES THEREIN SET FORTH.

IN WITNESS WHEREOF, I HAVE HEREUNTO SET MY HAND AND OFFICIAL SEAL THE DAY AND YEAR
LAST ABOVE WRITTEN.

Barbara J. Layton
BARBARA J. LAYTON, NOTARY PUBLIC

MY COMMISSION EXPIRES FEBRUARY 1, 1968