

STATE OF KANSAS  
STATE CORPORATION COMMISSION

WELL PLUGGING RECORD

Give All Information Completely  
Make Required Affidavit  
Mail or Deliver Report to:  
Conservation Division  
State Corporation Commission,  
800 Bittling Building,  
Wichita, Kansas

FORMATION PLUGGING RECORD

Strike out upper line  
when reporting plug-  
ging off formations.

*Attention Melvin Lee,  
Bittling Bldg.*

Reno County. Sec. 27 Twp. 24 Rge. 5 (EX) (W)

Location as "NE 1/4 NW 1/4 SW 1/4" or footage from lines SE Corner SW 1/4

Lease Owner Derby Oil Company

Lease Name Schrock Well No. 8

Office Address Wichita, Kansas

Character of Well (Completed as Oil, Gas or Dry Hole) Dry Hole

Date, well completed April 24, 1936

Application for plugging filed April 15, 1936 1936

Application for plugging approved April 15, 1936

Plugging Commenced April 22, 1936


Plugging Completed April 24, 1936

Reason for abandonment of well or producing formation Dry

If a producing well is abandoned, date of last production 193

Was permission obtained from the Conservation Division or its agents before plugging was com-  
menced? Yes

NORTH

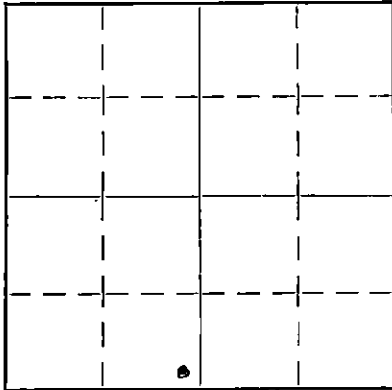

Locate well correctly on above  
Section Plat

Name of Conservation Agent who supervised plugging of this well Alexander

Producing formation Depth to top Bottom Total Depth of Well Feet

Show depth and thickness of all water, oil and gas formations.

OIL, GAS OR WATER RECORDS

CASING RECORD

Formation	Content	From	To	Size	Put In	Pulled Out
Log filed with application				15 1/2	170'	
				13-3/8	503'	
				7"	3848'	2380

Describe in detail the manner in which the well was plugged, indicating where the mud fluid was placed and the method or methods used in introducing it into the hole. If cement or other plugs were used, state the character of same and depth placed, from feet to feet for each plug set.

Ripped casing 2380'

Filled sand cuttings to 510'

Cemented 20 sax into 13-3/8" casing

Sand cuttings 5' from top of 13-3/8"

Cemented to 1' over top of 13-3/8" casing

Soil to top of surface

*Rec'd  
5-1-36*

**PLUGGING**  
FILE SEC 27 T 24 R 5 W  
BOOK PAGE 41 LINE 47

(If additional description is necessary use BACK of this sheet)

Correspondence regarding this well should be addressed to O. B. Mullins

Address % Derby Oil Company  
Wichita, Kansas

STATE OF KANSAS, COUNTY OF SEDGWICK, ss.

(employee of owner) or (owner or operator) of the above-described well,  
being first duly sworn on oath, says: That I have knowledge of the facts, statements, and matters herein contained and the log of the above-described well as filed and that the same are true and correct. So help me God

(Signature) O. B. Mullins

*O. B. Mullins  
% Derby Oil Co.*

(Address)

SUBSCRIBED AND SWORN to before me this 28 day of April, 1936

*Grace Lockyer*

My commission expires Jan 21, 1939

SCHROCK NO. 78

Commenced: November 25, 1936  
Completed: February 17, 1936  
Total Depth: 3965  
P.B. to 3505  
Elevation: 1546

SE SW 27-24-5W  
Reno County, Kansas  
Drlg. Contr: The McPherson Drlg. Co.  
Steam Rotary: Fuel-Gas  
Completed w/ Company Tools.

Casing

170 ft. of 15 $\frac{1}{2}$ " L.W. 70# Casing - Cemented with 170 sacks  
503 ft. of 13  $\frac{3}{8}$ " Casing - Cemented with 130 sacks of cement  
3848ft. of 7" A.P.I. Casing - Cemented with 200 sacks of cement

Drillers Log

Surface Clay	30	Sandy Lime	2670
Red Rock	80	Lime	2695
Sand	120	Broken Lime	2704
Shale and Lime Shells	170	Top K. C. Lime	2704
Shale and Broken Lime	320	Lime	2857
Broken Lime	504	Broken Lime	2889
Salt	594	Lime	2899
Shale	630	Lime Break	2906
Lime	700	Shale	2935
Broken Lime	845	Broken Lime	2964
Shale	895	Sandy Lime	2995
Broken Lime	1005	Shale	3015
Shale	1070	Lime	3027
Broken Lime	1157	Shale	3070
Shale	1177	Lime	3104
Broken Lime	1394	Broken Lime	3110
Shale	1460	Lime	3125
Broken Lime	1475	Shale	3128
Shale	1503	Lime	3150
Broken	1520	Shale	3305
Shale	1555	Broken Lime	3322
Broken Lime	1560	Shale	3360
Shale	1680	Broken Lime	3362
Broken Lime	1884	Shale	3402
Lime	1894	Chat	3507
Broken Lime	1920	Chat and Lime	3526
Shale	1968	Lime	3530
Broken Lime	2040	Chat and Lime	3535
Shale	2100	Lime	3620
Broken Lime	2110	Shale	3701
Shale	2154	Shale, Sandy	3728
Broken Lime	2330	Shale	3760 $\frac{1}{2}$
Shale	2344	Laminated Sand and Shale	3765
Broken Lime	2409	Very Fine Compact Land w/ Oil Stain	
Lime	2490	Shale, Black	3767 $\frac{1}{2}$
Broken Lime	2530	Shale	3776
Shale	2590	Sandy Shale	3777 $\frac{1}{2}$
Sandy Lime	2610	Shale w/ sand Ledges	3786 $\frac{1}{2}$
Lime	2620		

## Rotary Coring Record

Green Grey Shale (Partially Dolomitic)	3793	Cored 3697 to 3702 - 4' Recovery
Shale	3802	" 3731 to 3740 - 8' "
Lime	3803	" 3740 to 3750 - 7 $\frac{1}{2}$ ' "
Broken Lime	3826	" 3758 to 3767 - 8' "
Crystalline Lime (Slight Oil Saturation)	3836	" 3767 $\frac{1}{2}$ to 3777 $\frac{1}{2}$ - 7' Recovery
Dense Lime	3842	" 3777 $\frac{1}{2}$ to 3786 $\frac{1}{2}$ - 9' "
Lime	3848	" 3786 $\frac{1}{2}$ to 3793 - 5' "
Green Gray Shale	3849	" 3826 to 3836 - 8' "
Sand, Clear, Fine	3852	" 3836 to 3842 - 6' "
Sand, Compact	3862	" 3842 to 3852 - 10' "
Oil Stain	3858-62	" 3852 to 3862 - 10' "
Sand (Partial Saturation)	3872 $\frac{1}{2}$	" 3862 to 3872 $\frac{1}{2}$ - 2 $\frac{1}{2}$ ' "
Run 7" A.L.I. Casing and Set at 3848 - (Cemented with 200 sacks)		

Standardized January 8, 1936

Top of Cement 3825

Out of Cement Plug at 3852

Hole filled with water to 2350

C. O. to 3873

Cemented back with 7 sacks of cement to 3851

Perforating Pipe 3828-3836

Corrected Measurements

Top of Plug 3845

Bottom of Core Hole 3870

Perforated w/ long knives - 3828-3826

Hole filled 125 ft. in 25 minutes - All water

Swabbing test - 10 Bbl. Water per Hour (No oil)

Drilled out cement plug - Drlg. Ahead

Cement 3851 - 3872

Wilcox Sand 3872 - 3876

State 3876 - 3877

Wilcox Sand - White 3877 - 3883

Shale, Blue 3883 - 3885

Lime, Sandy, White 3885 - 3890

Shale, Green 3890 - 3892

Shale &amp; P of Iron 3892 - 3894

Lime, Hard 3892 - 3898

Shale, Blue 3898 - 3900

Lime, Gray (P of Iron) 3900 - 3903

Shale, Blue 3903 - 3908

Lime, White 3908 - 3912

Shale, Blue 3912 - 3915

Shale, sandy, hard 3915 - 3926

Shale, sandy 3926 - 3931

Reduced hole to 5" at 3931

Sand, white, hard 3931 - 3943

Dolomite 3943 - 3965

Inc. of Water at 3964-65

Run 40 sacks of Ancore Cement with Dump Bailer

Top of Cement 3827

Perforated at 3415 - (Top of chat showed cement)

Perforated at 3460-59-58-57-56-55-52-50 (Gas and Water at 3450)  
 Filled up to 3454 with chat  
 (Oakum, Lead Wool and 6 Sacks of Cement)  
 Filled hole w/ water after cementing  
 Top of cement 3420  
 C. O. to 3485  
 Making  $3\frac{1}{2}$  Bbls. of Water per Hour  
 Perforated 3460-3465  
 Tested  $1\frac{1}{2}$  Bbls. of oil and 6 Bbls. of water per hour  
 Perforated 3465-3470 and 3470-3475 - No increase of oil  
 C. O. to 3505'  
 Perforating 3495-3500 - No increase  
 Perforating 3460 to 3470 to 3475 - No increase  
 Perforating 3420 to 3430  
 Test swabbing off bottom - 2 Barrels of Oil and 4 Barrels of water per hour  
 Run Tubing February 17, 1936  
 State Potential Pumping Test - 2-22-36  
 43 Oil and 147 Water in 24 Hours

Top of Lansing	2704
Top of Mississippi Lime	3402
Base of Mississippi Lime	3621
Top of Sandy Zone in Kinderhook Shale	3760
Top of Sylvian Shale	3776
Top of Viola Lime	3828
Top of Simpson	3848
Top of Wilcox Sand	3849
Top of Siliceous Lime	3843
Total Maximum Depth Drilled	3965

3/12/36 - Cemented into formation through tubing. 14 sacks into formation.

Top of cement 3439' - Water was coming into hole between 3448 and 3450  
 Base of cement 3475'  
 Bailed hole dry

Perforated 3460' to 70' (10 holes) Show of oil and water  
 Perforated 3470' to 75' (5 holes)  
 Perforated 3460 to 75 (24 holes)  
 2/3 Bailer Oil - Show of water

Perforated 3475' to 3485'	8 holes - No change
" 3485 to 3500'	10 holes - No Change
" 3430	$\frac{1}{2}$ H Gas
" 3430 to 3420	8 holes
" 3436 to 3440	4 holes
" 3420 to 3455	37 holes
" 3460 to 3440	15 holes

Treated 1000 gal. acid followed with 142 bbls. of oil. Hole full water.

Dumped 40 sacks cement. 3511' filled up to 3270'  
 Ripped casing 2715' - Recemented 50 sacks  
 Drilled out cement. Hole full water  
 Pumped down test plug which stopped 2530'  
 Recemented 25 sacks cement. Filled 2500' to 2530'  
 Drilled out. Hole full water. Perforated with Hinderlitor 4-way ripper 2531'  
 Cemented 50 sax cement 2500' to 2530'. Drilled out. Swabbed to 2250' Water  
 broke in again