


STATE OF KANSAS
STATE CORPORATION COMMISSION

Give All Information Completely
Make Required Affidavit
Mail or Deliver Report to:
Conservation Division
State Corporation Commission
800 Bittling Building
Wichita, Kansas

WELL PLUGGING RECORD

NORTH

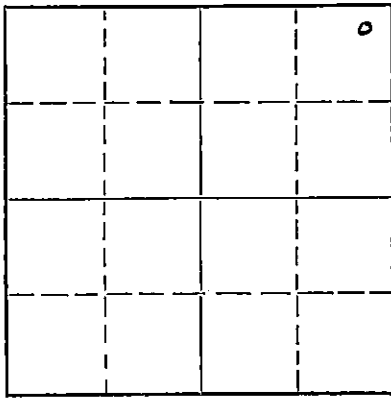

Locate well correctly on above
Section Plat

Stafford County. Sec. 3 Twp. 24 Rge. 14 (E) W (W)
Location as "NE/CNW/SW" or footage from lines NE NE NE
Lease Owner Harms-Burt Drilling Co.
Lease Name Aitken Well No. 1
Office Address Box 184, Great Bend, Kansas
Character of Well (completed as Oil, Gas or Dry Hole) Dry Hole
Date well completed March 12 1956
Application for plugging filed " 12 1956
Application for plugging approved " 12 (verbally) 1956
Plugging commenced " 12 1956
Plugging completed " 12 1956
Reason for abandonment of well or producing formation Dry hole

If a producing well is abandoned, date of last production 19
Was permission obtained from the Conservation Division or its agents before plugging was commenced? yes

Name of Conservation Agent who supervised plugging of this well R.M. Brundege, Box 283, Hoisington, Kansas
Producing formation Depth to top Bottom Total Depth of Well 4207 Feet
Show depth and thickness of all water, oil and gas formations.

OIL, GAS OR WATER RECORDS

CASING RECORD

FORMATION	CONTENT	FROM	TO	SIZE	PUT IN	PULLED OUT
Surface		0	210'	8 5/8"	210'	none

Describe in detail the manner in which the well was plugged, indicating where the mud fluid was placed and the method or methods used in introducing it into the hole. If cement or other plugs were used, state the character of same and depth placed, from feet to feet for each plug set.

Filled hole with mud from total depth to 210' with plug set at 210' and 20 sacks
of cement on top of plug. Filled with mud to 30' set plug with 10 sacks
of cement on top of plug.

RECEIVED
STATE CORP. COM.
Recd
MAR 30 1956
CONSERVATION DIVISION
KANSAS

(If additional description is necessary, use BACK of this sheet)
Name of Plugging Contractor Harms-Burt Drilling Co.
Address Box 184, Great Bend, Kansas

STATE OF Kansas, COUNTY OF Barton, ss.
Allan Harms (employee of owner) or (owner or operator) of the above-described

well, being first duly sworn on oath, says: That I have knowledge of the facts, statements, and matters herein contained and the log of the above-described well as filed and that the same are true and correct. So help me God.

(Signature) Allan Harms

Box 184, Great Bend, Kansas

(Address)

SUBSCRIBED AND SWORN TO before me this 29 day of March, 1956

Mary E. Van Pelt

Notary Public.

My commission expires 1-20-58

24-7866-5 3-53-20M

PLUGGING
FILE SEC 3 T 24 R 14 W
BOOK PAGE 45 UNIT 29

Driller's Log

Company: Harms-Burt Drilling Co.
Farm: Aitken No. 1

NE NE NE Section 3-24-11W
Stafford County, Kansas

Commenced: February 24, 1956

Completed: March 12, 1956

Elevation: 1950 K B

0 - 165	Sand & clay	2955 - 3085	Shale & lime
165 - 210	Shale	3085 - 3231	Lime & shale
210 - 300	Shale & sand	3231 - 3335	Shale & lime
300 - 345	Red bed	3335 - 3490	Lime
345 - 475	Shale & sand	3490 - 3580	Shale
475 - 863	Red bed	3580 - 3620	Shale & lime
863 - 890	Anhydrite	3620 - 3890	Lime
890 - 1020	Shale & shells	3890 - 3975	Lime & shale
1020 - 1500	Shale & red bed	3975 - 3993	Conglomerate
1500 - 1920	Lime & shale	3993 - 4036	Lime & chert
1920 - 2030	Lime	4036 - 4105	Chert
2030 - 2195	Lime & shale	4105 - 4155	Shale & sand
2195 - 2275	Lime	4155 - 4175	Lime & shale
2275 - 2425	Shale	4175 - 4207	Lime
2425 - 2540	Shale & shells	4207	Total Depth
2540 - 2690	Shale & lime streaks		
2690 - 2955	Shale		

Set 210' of 8 5/8" surface pipe. Cemented with 200 sacks of common cement and 4 sacks of calcium chloride. Cement circulated.

Tops: Anhydrite 863
Lansing KC 3628
Viola 3996
Simpson 4120
Arbuckle 4175

Drill Stem Tests: No. 1 3735- 3757 Open 45 min. shut in 20 min.
Recovered 30 ft. of mud. No BHP
No. 2 3950- 3993 Open 1 hr. shut in 20 min.
Recovered 150 ft. gas cut mud.
IFP 230# FFP 270# BHP 1280#
No. 3 4127- 4142 Open 70 min. shut in 20 min.
Recovered 200' salt water.
IFP 32# FFP 98# BHP 1278#

Ran Electric Log
Dry, plugged and abandoned.

Affidavit: State of Kansas, County of Barton, SS:

I, Allan Harms, of Harms-Burt Drilling Co., being first duly sworn on oath state that I have knowledge of the facts, statements, and matters herein contained and same are true and correct.

Signed Allan Harms

Subscribed and sworn to before me this 29 day of March, 1956.

Comm. Exp. 1-20-58

Mary E. Van Pelt
Notary Public

NE
STATE CO

MAR 30 1956

CONSERVATION DIVISION
Wichita, Kansas

PLUGGING
FILE SEC 3-1-24-14W
DOCK PAGE 45 LINE 29