


STATE OF KANSAS
STATE CORPORATION COMMISSION

Give All Information Completely
Make Required Affidavit
Mail or Deliver Report to:
Conservation Division
State Corporation Commission
212 North Market, Insurance Bldg.
Wichita, Kansas

WELL PLUGGING RECORD

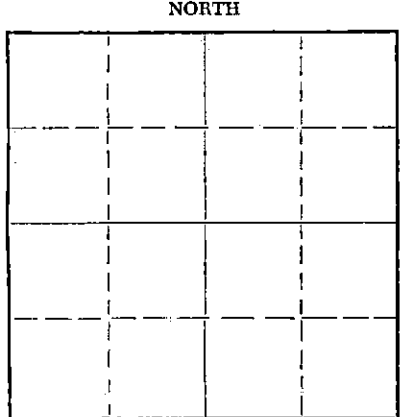

Stafford County, Sec. 3 Twp. 24 Rge. 14 XXXX (W)

Location as "NE/CNW%SW%" or footage from lines SW SE SW
Lease Owner E. K. Edmiston
Lease Name Gray B Well No. 1
Office Address 802 Union National Bldg., Wichita, Kansas
Character of Well (completed as Oil, Gas or Dry Hole) dry hole
Date well completed 12-29-59 19
Application for plugging filed 31-60 19
Application for plugging approved 3-1-60 19
Plugging commenced 3-1-60 19
Plugging completed 3-1-60 19
Reason for abandonment of well or producing formation
Commercial quantities of oil not found
If a producing well is abandoned, date of last production 19
Was permission obtained from the Conservation Division or its agents before plugging was commenced? yes

Name of Conservation Agent who supervised plugging of this well Frank Broadfoot, St. John, Kansas
Producing formation _____ Depth to top _____ Bottom _____ Total Depth of Well 4172' feet
Show depth and thickness of all water, oil and gas formations.

OIL, GAS OR WATER RECORDS

CASING RECORD

FORMATION	CONTENT	FROM	TO	SIZE	PUT IN	PULLED OUT
				4 1/2"	4166	3735.31

Describe in detail the manner in which the well was plugged, indicating where the mud fluid was placed and the method or methods used in introducing it into the hole. If cement or other plugs were used, state the character of same and depth placed, from _____ feet to _____ feet for each plug set.

Sand to 3990' w/5 sx cement
Pump load to mud, plug and 75 sx cem
Filling surface pipe from 225' to base of cellar with cement.

RECEIVED
STATE CORPORATION COMMISSION
3-17-60
MAR 17 1960
CONSERVATION DIVISION
Wichita, Kansas

(If additional description is necessary, use BACK of this sheet)
Name of Plugging Contractor Southwest Casing Pulling Co., Inc.
Address P.O. Box 364 - Great Bend, Kansas

STATE OF Kansas, COUNTY OF Sedgwick, ss.
E. K. Edmiston (employer of owner) or (operator) of the above-described well, being first duly sworn on oath, says: That I have knowledge of the facts, statements and matters herein contained and the log of the above-described well as filed and that the same are true and correct. So help me God.

(Signature) *E. K. Edmiston*
802 Union National Bldg.
(Address)

SUBSCRIBED AND SWORN TO before me this 16 day of March, 19 60

Frances Markley
Notary Public.

My commission expires June 25, 1960



DRY "B" one of the wells

WELL LOG BUREAU—KANSAS GEOLOGICAL SOCIETY
508 East Murdock, Wichita, Kansas


Company- STRATA DRILLING, INC.
Farm- Davis No. 1

SEC. 3 T. 24
SW SE SW

Y. 14W

Total Depth. 4240'
Comm. 11-12-57 Comp. 11-25-57
Shot or Treated.
Contractor. Strata Drilling, Inc.
Issued. 2-22-58

County Stafford
KANSAS

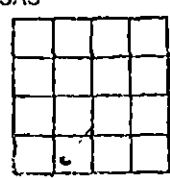

CASING:
8 5/8" 225' cem w/180 sx

Elevation. 1957' DF

Production. Dry

Figures indicate Bottom of Formations.

surface soil & water sands	125
shale	225
shale & sand	400
shale	575
red bed	880
Anhydrite	915
shale & shells	1620
shale & lime	2110
lime	2200
lime & shale	3610
lime	4240
Total Depth	

TOPS:

Anhydrite	880
Heebner	3494
Brown Lime	3611
Lansing	3630
Conglomerate	3971
Viola	3999
Simpson Shale	4145
Arbuckle	4211

DST #1. @ 4079'. Tool open one hour.
Rec. 30' mud IFP 60 lbs. FFP
60 lbs. BHP 1400 lbs.