


STATE OF KANSAS
STATE CORPORATION COMMISSION

WELL PLUGGING RECORD

Give All Information Completely
Make Required Affidavit
Mail or Deliver Report to:
Conservation Division
State Corporation Commission
211 No. Broadway
Wichita, Kansas

Stafford County. Sec. 3 Twp. 24 Rge. (E) 14 (W)
Location as "NE/CNW%SW%" or footage from lines. SW SE SW
Lease Owner Strata Drilling, Inc.
Lease Name Davis Well No. 1
Office Address Box 355, Great Bend, Kansas
Character of Well (completed as Oil, Gas or Dry Hole) Dry Hole
Date well completed November 25, 1957 19
Application for plugging filed November 25, 1957 19
Application for plugging approved November 26, 1957 19
Plugging commenced November 25, 1957 19
Plugging completed November 25, 1957 19
Reason for abandonment of well or producing formation _____

NORTH

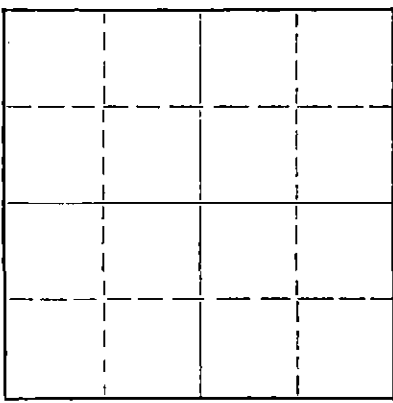

Locate well correctly on above
Section Plat

If a producing well is abandoned, date of last production _____ 19____
Was permission obtained from the Conservation Division or its agents before plugging was commenced? Yes

Name of Conservation Agent who supervised plugging of this well Don Truan, Russell, Kansas
Producing formation _____ Depth to top _____ Bottom _____ Total Depth of Well _____ Feet
Show depth and thickness of all water, oil and gas formations.

OIL, GAS OR WATER RECORDS

CASING RECORD

| FORMATION | CONTENT | FROM | TO | SIZE | PUT IN | PULLED OUT |
|-----------|---------|------|----|--------|--------|------------|
| | | | | 8-5/8" | 225' | |
| | | | | | | |
| | | | | | | |
Describe in detail the manner in which the well was plugged, indicating where the mud fluid was placed and the method or methods used in introducing it into the hole. If cement or other plugs were used, state the character of same and depth placed, from _____ feet to _____ feet for each plug set.
Plugged hole with 30 sacks of cement on plug @ 250', 10 sacks on plug @ 40' through drilling pipe. Job completed 11-25-1957, 2:00 A. m.

RECEIVED
STATE CORPORATION COMMISSION
12-19-57
DEC 19 1957

CONSERVATION DIVISION
Wichita, Kansas

(If additional description is necessary, use BACK of this sheet)
Name of Plugging Contractor Strata Drilling, Inc.
Address Box 355, Great Bend, Kansas

STATE OF Kansas, COUNTY OF Barton, ss.
Jim B. McWilliams (employee of owner) or (owner or operator) of the above-described well, being first duly sworn on oath, says: That I have knowledge of the facts, statements, and matters herein contained and the log of the above-described well as filed and that the same are true and correct. So help me God.

(Signature) Jim B. McWilliams
Jim B. McWilliams
Box 355, Great Bend, Kansas
(Address)

SUBSCRIBED AND SWORN to before me this 29 day of November, 19 57

My commission expires November 9, 1959
Robert E. Southern
Robert E. Southern Notary Public.

PLUGGING
FILE SEC 3 T 24 R 14
BOOK PAGE 63 LINE 93

DRILLERS LOG

#1 Davis

CASING RECORD:
225' of new 8-5/8"
surface casing

COMPANY: Strata Drilling, Inc.

CONTRACTOR: Strata Drilling, Inc.

DESCRIPTION:
SW SE SW
Sec. 3-24-14W
Stafford Co., Kan.

TOTAL DEPTH:
4240'

COMMENCED: November 12, 1957

COMPLETED: November 25, 1957

ELEVATION: 1957' DF
1954' GL

| <u>FORMATION</u> | <u>FROM</u> | <u>TO</u> | <u>REMARKS</u> |
|----------------------------|-------------|-----------|--|
| Surface soil & water sands | 0 | 125 | Ran 225' new 8-5/8" surface casing; cemented w/180 sacks of cement, 2% cc. DST #1. @ 4079'. Tool open one hour. Recovered 30' mud IFP 60 lbs. FFP 60 lbs. BHP 1400 lbs. |
| Shale | 125 | 225 | |
| Shale & Sand | 225 | 400 | |
| Shale | 400 | 575 | |
| Red Bed | 575 | 880 | |
| Anhydrite | 880 | 915 | |
| Shale & Shells | 915 | 1620 | |
| Shale & Lime | 1620 | 2110 | |
| Lime | 2110 | 2200 | |
| Lime & Shale | 2200 | 3610 | |
| Lime | 3610 | 4240 | |

TOTAL DEPTH 4240'

RECEIVED
STATE CORPORATION COMMISSION
DEC 16 1957
CORPORATION DIVISION
Kansas

STATE OF KANSAS }
COUNTY OF BARTON }

ss:

I certify that this is a true and correct copy of the above log to the best of my knowledge.

STRATA DRILLING, INC.

Jim B. McWilliams
Jim B. McWilliams, Sec-Tres.

Subscribed and sworn to before me this 12th day of December, 1957.

Robert E. Southern
Robert E. Southern Notary Public

My Commission Expires:

November 9, 1959

PLUGGING
FILE SEC 3 T 24 R 14W
BOOK PAGE 63 LINE 43