

STATE OF KANSAS
STATE CORPORATION COMMISSION

WELL PLUGGING RECORD

Give All Information Completely
Make Required Affidavit
Mail or Deliver Report to:
Conservation Division
State Corporation Commission
211 No. Broadway
Wichita, Kansas

STAFFORD County, Sec. 22 Twp. 24 Rge. 12W (E) (W)

Location as "NE/CNWxSWx" or footage from lines SW SE SW

Lease Owner SANTA FE PIPE & SUPPLY

Lease Name ERHART Well No. 1

Office Address P. O. BOX 562 - GREAT BEND, KANSAS

Character of Well (completed as Oil, Gas or Dry Hole)

Date well completed 19__

Application for plugging filed JUNE 26 19 59

Application for plugging approved JUNE 30 19 59


Plugging commenced JUNE 25 19 59

Plugging completed JUNE 28 19 59

Reason for abandonment of well or producing formation DEPLETED

If a producing well is abandoned, date of last production 19__

Was permission obtained from the Conservation Division or its agents before plugging was commenced?

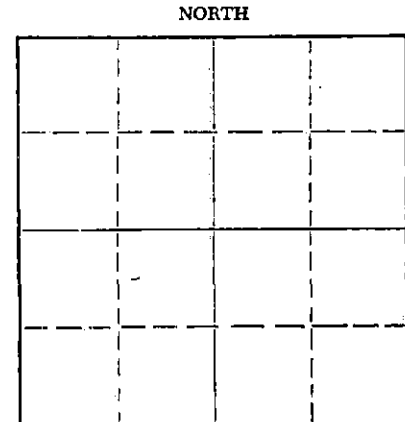

Locate well correctly on above Section Plat

Name of Conservation Agent who supervised plugging of this well MR. FRANK BROADFOOT

Producing formation Depth to top Bottom Total Depth of Well 3560' Feet

Show depth and thickness of all water, oil and gas formations.

OIL, GAS OR WATER RECORDS

CASING RECORD

FORMATION	CONTENT	FROM	TO	SIZE	PUT IN	PULLED OUT
				8 5/8	320'	none
				5 1/2"	4079'	3212'

Describe in detail the manner in which the well was plugged, indicating where the mud fluid was placed and the method or methods used in introducing it into the hole. If cement or other plugs were used, state the character of same and depth placed, from feet to feet for each plug set.

SAND	3560'	-	3500'
CEMENT	3500'	-	3470'
MUD	3470'	-	300'
ROCK	300'	-	290'
CEMENT	290'	-	215'
MUD	215'	-	35'
CEMENT	35'	-	0'

RECEIVED
STATE CORPORATION COMMISSION
JUL 30 1962
CONSERVATION DIVISION
Wichita, Kansas

(If additional description is necessary, use BACK of this sheet)
Name of Plugging Contractor GLENN & SMITH PIPE PULLING COMPANY
Address P. O. BOX 114 - ELLINWOOD, KANSAS

STATE OF KANSAS, COUNTY OF BARTON, ss.
J. L. Nutt (employee of owner) or (owner or operator) of the above-described well, being first duly sworn on oath, says: That I have knowledge of the facts, statements, and matters herein contained and the log of the above-described well as filed and that the same are true and correct. So help me God.

(Signature) [Signature]
P. O. BOX 562 - GREAT BEND, KANSAS (Address)

SUBSCRIBED AND SWORN TO before me this 26 day of JULY, 19 62
Carmen Reinhardt Leiker
Carmen Reinhardt Leiker Notary Public.

My commission expires Jan. 26, 1963

WELL LOG BUREAU—KANSAS GEOLOGICAL SOCIETY
503 East Murdock, Wichita, Kansas


COPY

Company- DEEP ROCK OIL CORP.
Farm- Erhart "A" No. 1

SEC. 22 T. 24 R. 12W
SW SE SW

Total Depth. 4082'
Comm. 4-18-53 Comp. 5--7-53
Shot or Treated.
Contractor. Honaker Drlg. Co.
Issued. 8-20-54

County Stafford
KANSAS

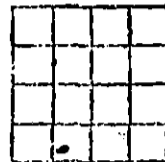

CASING:
8 5/8" 320' ccm w/200 sx
5 1/2" 4079' ccm w/175 sx

Elevation. 1874'

Production. BHB 3000 & NW

Figures indicate Bottom of Formations.

clay and sand	140
clay and sand	324
red bed	685
anhydrite	715
shale & shells	1555
shells, shale & lime	1695
lime & shale	2585
shale & lime	2765
lime & shale	3025
lime	3405
lime & shale	3531
lime	3852
lime & shale	3900
lime	3915
lime, chert & shale	4062
lime & shale	4082
Total Depth	

Tops: Scout	
Heebner	3325
Brown Lime	3477
Lensing	3506
Viola	3899
Simpson Shale	4027
Arbuckle	4078

RECEIVED
STATE CORPORATION COMMISSION
JUL 30 1962
CONSERVATION DIVISION
Wichita, Kansas