


STATE OF KANSAS  
STATE CORPORATION COMMISSION

WELL PLUGGING RECORD

Give All Information Completely  
Make Required Affidavit  
Mail or Deliver Report to:  
Conservation Division  
State Corporation Commission  
800 Bittling Building  
Wichita, Kansas

Stafford County, Sec. 22 Twp. 24 Rge. 12 (E) W (W)  
Location as "NE/CNW/SW" or footage from lines \_\_\_\_\_  
Lease Owner Westpan Hydrocarbon Company  
Lease Name Crawford Well No. 2  
Office Address 2421 10th Street  
Character of Well (completed as Oil, Gas or Dry Hole) Dry Hole  
Date well completed 5-4-54 19 54  
Application for plugging filed 5-4 19 54  
Application for plugging approved 5-4 19 54  
Plugging commenced 5-4 19 54  
Plugging completed 5-4 19 54  
Reason for abandonment of well or producing formation Dry Hole

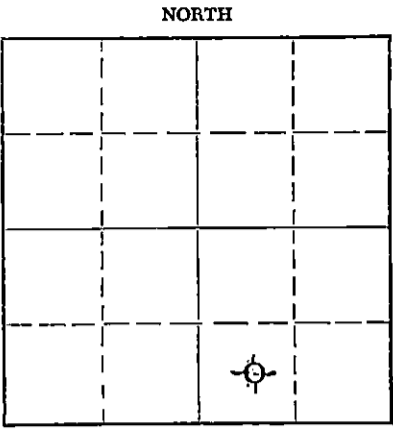

Locate well correctly on above  
Section Plat

If a producing well is abandoned, date of last production \_\_\_\_\_ 19 \_\_\_\_  
Was permission obtained from the Conservation Division or its agents before plugging was commenced? Yes

Name of Conservation Agent who supervised plugging of this well M. A. Rives  
Producing formation \_\_\_\_\_ Depth to top \_\_\_\_\_ Bottom \_\_\_\_\_ Total Depth of Well 4166 Feet  
Show depth and thickness of all water, oil and gas formations.

OIL, GAS OR WATER RECORDS

CASING RECORD

FORMATION	CONTENT	FROM	TO	SIZE	PUT IN	PULLED OUT
				8 5/8"	314'	None

Describe in detail the manner in which the well was plugged, indicating where the mud fluid was placed and the method or methods used in introducing it into the hole. If cement or other plugs were used, state the character of same and depth placed, from \_\_\_\_\_ feet to \_\_\_\_\_ feet for each plug set.

Hole filled to 300' with heavy rotary mud  
Plug set at 300' W/30 sx. cement  
Filled hole to 35' with heavy rotary mud  
Set top plug at 35' and hole filled to  
surface W/10 sx. cement

(If additional description is necessary, use BACK of this sheet)

Name of Plugging Contractor Hilton Drilling Company, Inc.  
Address 2421 10th Street

STATE OF Kansas, COUNTY OF Barton, ss.  
J. L. Haines (employee of owner) or (owner or operator) of the above-described well, being first duly sworn on oath, says: That I have knowledge of the facts, statements, and matters herein contained and the log of the above-described well as filed and that the same are true and correct. So help me God.

(Signature) J. L. Haines  
P. O. Box 30, Larned, Kansas  
(Address)

SUBSCRIBED AND SWORN TO before me this 11th day of May, 19 54

My commission expires August 29, 1955

Emmanuel Sarge Notary Public.

24-7368-5 3-53-20M  
**PLUGGING**  
FILE SEC 22 T 24 R 12  
BOOK PAGE 32 LINE 20

RECEIVED  
MAY 12 1954  
CONSERVATION DIVISION  
WICHITA, KANSAS

