


STATE OF KANSAS  
STATE CORPORATION COMMISSION

Form CP-4

Give All Information Completely  
Make Required Affidavit  
Mail or Deliver Report to:  
Conservation Division  
State Corporation Commission  
211 No. Broadway  
Wichita, Kansas

## WELL PLUGGING RECORD

NORTH

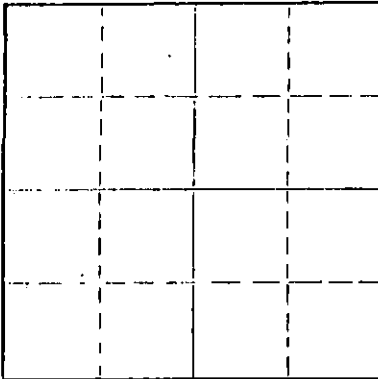

Locate well correctly on above  
Section Plat

Stafford County, Sec. 23 Twp. 24S Rge. (E) 12 (W)  
Location as "NE/CNW&SW" or footage from lines NW NE SE  
Lease Owner Shawver Armour, Inc.  
Lease Name Smith Well No. B-1  
Office Address 817 Central Building Wichita, Kansas  
Character of Well (completed as Oil, Gas or Dry Hole) Dry Hole  
Date well completed October 24 19 64  
Application for plugging filed October 24 19 64  
Application for plugging approved October 24 19 64  
Plugging commenced October 24 19 64  
Plugging completed October 24 19 64  
Reason for abandonment of well or producing formation Dry Hole

If a producing well is abandoned, date of last production 19  
Was permission obtained from the Conservation Division or its agents before plugging was commenced? Yes

Name of Conservation Agent who supervised plugging of this well Herman Justice  
Producing formation Depth to top Bottom Total Depth of Well 4070 Feet  
Show depth and thickness of all water, oil and gas formations.

## OIL, GAS OR WATER RECORDS

## CASING RECORD

| FORMATION | CONTENT | FROM | TO  | SIZE  | PUT IN | PULLED OUT |
|-----------|---------|------|-----|-------|--------|------------|
| Surface   | Water   | -0-  | 293 | 8 5/8 | 293    | none       |
|           |         |      |     |       |        |            |
|           |         |      |     |       |        |            |
Describe in detail the manner in which the well was plugged, indicating where the mud fluid was placed and the method or methods used in introducing it into the hole. If cement or other plugs were used, state the character of same and depth placed, from feet to feet for each plug set.

Plug orders heavy mud to 180'  
#1 Plug 180' Howco plug 1/4 sk Hulls 20 sks. cement  
Heavy mud to 40'  
#2 Plug 40' Howco plug 1/4 sk Hulls 10 sks. cement  
Bridge rat hole 7' 2 sks cement

RECEIVED  
STATE CORPORATION COMMISSION

NOV 2 1964  
11-2-64

CONSERVATION DIVISION  
Wichita, Kansas

(If additional description is necessary, use BACK of this sheet)  
Name of Plugging Contractor Shawver Armour, Inc.  
Address 817 Central Building Wichita, Kansas

STATE OF KANSAS, COUNTY OF SEDGWICK, ss.  
Don Shawver

(employee of owner) or (owner or operator) of the above-described well, being first duly sworn on oath, says: That I have knowledge of the facts, statements, and matters herein contained and the log of the above-described well as filed and that the same are true and correct. So help me God.

(Signature)

Don Shawver

817 Central Bldg. Wichita, Kansas

(Address)

Subscribed and Sworn to before me this 28th day of October, 19 64.

My commission expires December 10, 1967

Claire Jones  
Notary Public.

## D R I L L E R ' S L O G

FARM NAME: Smith B-1 LOCATION: NW NE SE Sec. 23-24S-12W  
Stafford County, Kansas

CONTRACTOR: SHAWVER ARMOUR, INC.

OWNER: SHAWVER ARMOUR, INC. ELEVATION: 1859 K. B.

COMMENCED: October 13, 1964 COMPLETED: October 24, 1964

CASING RECORD: 293' 8 5/8" w/240 sacks cement & 5 sacks cc

FORMATION:

|               |      |
|---------------|------|
| Red Bed       | 1000 |
| Shale & Lime  | 1635 |
| Lime & Shale  | 2485 |
| Shale & Lime  | 2715 |
| Lime & Shale  | 3478 |
| Lansing       | 3511 |
| Lime          | 3722 |
| Lime & Shale  | 3898 |
| Viola         | 3911 |
| Lime          | 3998 |
| Simpson Shale | 4014 |
| Simpson Sand  | 4059 |
| Arbuckle      | 4070 |

Rotary Total Depth 4070

TOPS:

|                     |      |
|---------------------|------|
| Heebner             | 3301 |
| Toronto             | 3316 |
| Douglas             | 3338 |
| Brown Lime          | 3454 |
| Lansing-Kansas City | 3483 |
| Base Kansas City    | 3743 |
| Marmaton            | 3776 |
| Kinderhook          | 3803 |
| Viola               | 3903 |
| Simpson Shale       | 3998 |
| Simpson Sand        | 4014 |
| Arbuckle            | 4059 |

NOV 2 1964

CONSERVATION DIVISION  
Wichita, Kansas

STATE OF KANSAS }  
SEDGWICK COUNTY } ss

I, Don Shawver, do hereby certify that the above log is a true and correct copy of the above captioned well as shown on the daily drilling reports.

SHAWVER ARMOUR, INC.

BY

Don Shawver

Subscribed and sworn to before me this  
28th day of October 1964.

My commission expires Dec. 10th, 1967

Claire Jones, Notary Public