


STATE OF KANSAS
STATE CORPORATION COMMISSION

WELL PLUGGING RECORD

Give All Information Completely
Make Required Affidavit
Mail or Deliver Report to:
Conservation Division
State Corporation Commission
800 Bitting Building
Wichita, Kansas

NORTH

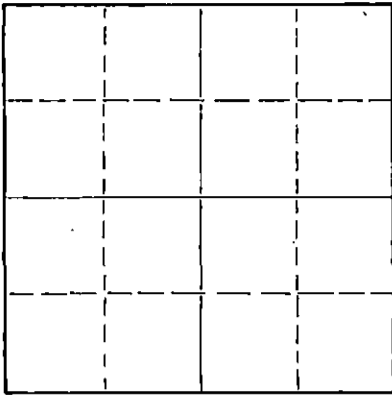

Locate well correctly on above
Section Plat

Stafford County. Sec. 9 Twp. 24 Rge. (E) 13 (W)
Location as "NE/CNW/SW" or footage from lines G-NW-NE-NW
Lease Owner Sunray Mid-Continent Oil Company
Lease Name Sutton Well No. 1
Office Address Box 788
Character of Well (completed as Oil, Gas or Dry Hole) Dry Hole
Date well completed April 28 1956
Application for plugging filed April 30 1956
Application for plugging approved April 30 1956
Plugging commenced April 28 1956
Plugging completed April 28 1956
Reason for abandonment of well or producing formation _____

If a producing well is abandoned, date of last production _____ 19____
Was permission obtained from the Conservation Division or its agents before plugging was commenced? Yes

Name of Conservation Agent who supervised plugging of this well R. M. Brundage
Producing formation _____ Depth to top _____ Bottom _____ Total Depth of Well 1,092 Feet
Show depth and thickness of all water, oil and gas formations.

OIL, GAS OR WATER RECORDS

CASING RECORD

FORMATION	CONTENT	FROM	TO	SIZE	PUT IN	PULLED OUT
				8 5/8	301	None

Describe in detail the manner in which the well was plugged, indicating where the mud fluid was placed and the method or methods used in introducing it into the hole. If cement or other plugs were used, state the character of same and depth placed, from _____ feet to _____ feet for each plug set.

Filled hole w/drlg mud to 300'. Set 1/3 sack hulls and Halliburton plug and 35 sacks cement. Ran 1/2 sack hulls, wood plug and 10 sacks cement at 35'. Fill with mud to surface.

RECEIVED
STATE CORPORATION COMMISSION
MAY 9 1956
5-9-56
CONSERVATION DIVISION
Wichita, Kansas

(If additional description is necessary, use BACK of this sheet)

Name of Plugging Contractor Halliburton Oil Well Cementing Company
Address Great Bend, Kansas

STATE OF Kansas, COUNTY OF Barton, ss.
Norman E. Montgomery (employee of owner) ~~owner~~ of the above-described well, being first duly sworn on oath, says: That I have knowledge of the facts, statements, and matters herein contained and the log of the above-described well as filed and that the same are true and correct. So help me God.

(Signature) Norman E. Montgomery
Box 788, Great Bend, Kansas
(Address)

SUBSCRIBED AND SWORN TO before me this 7 day of May, 1956

My commission expires Dec 24, 1956

[Signature]
Notary Public.

PLUGGING
MAY SEC 9 T 24 R 13W
BOOK PAGE 58 LINE 3

Sunray Mid-Continent Oil Company
Tulsa, Oklahoma

Tulsa, Oklahoma
May 1, 1956

CONTRACTOR: Stickle Drilling Company
Drilling Commenced: April 14, 1956
Drilling Completed: April 28, 1956

Sutton #1 - NW/4 NE NW,
Section 9-24S-14W,
Stafford County, Kansas.

DRILLERS LOG

Depth Figures Indicate Base of Formation:

Sand	160
Shale & Shells	225
Shale	270
Sand	285
Shale	785
Anhydrite	806
Shale	1100
Shale & Shells	1605
Shale	1710
Lime	1830
Lime & Shale	2480
Shale & Lime	2625
Shale	2995
Lime & Shale	3135
Chalky Lime & Shale	3270
Lime & Shale	3620
Lime & Shale	3653
Lime	3738
Lime & Shale	3840
Lime & Shale w/Chert	3881
Viola	3895
Lime	3932
Cherty Lime (Viola)	3960
Viola	3981
Lime & Shale	4037
Simpson Sand	4044
Sand, Shale & Lime	4066
Arbuckle	4092 TD

I, Frank E. Stickle, hereby certify the above to be a true and complete Drillers Log of Sunray Mid-Continent Oil Company's Sutton #1 - NW NE NW - Section 9-24S-13W, Stafford County, Kansas.

Frank E. Stickle

Frank E. Stickle

Lillian T. Bonham
Notary Public

February 13, 1960
My Commission Expires

RECEIVED
STATE CORPORATION

MAY 5 1956
CONSERVATION
Wichita, Kan.

PLUGGING
BOOK PAGE 58 LINE 3