


STATE OF KANSAS
STATE CORPORATION COMMISSION

Form CP-4

Give All Information Completely
Make Required Affidavit
Mail or Deliver Report to:
Conservation Division
State Corporation Commission
211 No. Broadway
Wichita, Kansas

WELL PLUGGING RECORD

NORTH

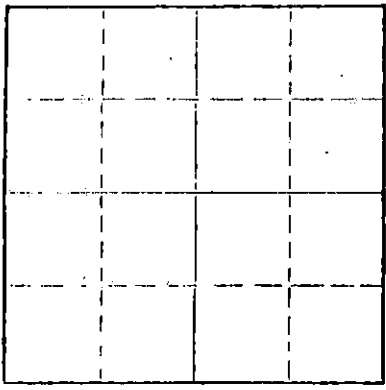

Stafford County, Sec. 7 Twp. 24 Rge. 14 (E) (W)
Location as "NE/CNW/SW" or footage from lines NE NW
Lease Owner March Drilling Company
Lease Name Owen Well No. 1
Office Address 531 Petroleum Bldg., Wichita, Kansas
Character of Well (completed as Oil, Gas or Dry Hole) dry hole
Date well completed 8-15 1964
Application for plugging filed 8-15 1964
Application for plugging approved 8-15 1964
Plugging commenced 8-15 1964
Plugging completed 8-15 1964
Reason for abandonment of well or producing formation none
If a producing well is abandoned, date of last production 19
Was permission obtained from the Conservation Division or its agents before plugging was commenced? Yes

Name of Conservation Agent who supervised plugging of this well _____
Producing formation _____ Depth to top _____ Bottom _____ Total Depth of Well 4255 Feet
Show depth and thickness of all water, oil and gas formations.

OIL, GAS OR WATER RECORDS

CASING RECORD

FORMATION	CONTENT	FROM	TO	SIZE	PUT IN	PULLED OUT
		0	210	8 5/8	210	-0-

Describe in detail the manner in which the well was plugged, indicating where the mud fluid was placed and the method or methods used in introducing it into the hole. If cement or other plugs were used, state the character of same and depth placed, from _____ feet to _____ feet for each plug set.

Filled hole with mud to 200', plug,
25 sks. cement. Mud to 40', plug,
1/2 sk. hulls, 10 sks. cement.

RECEIVED
STATE CORPORATION COMMISSION
8-20-64
AUG 20 1964

CONSERVATION DIVISION
Wichita, Kansas

(If additional description is necessary, use BACK of this sheet)
Name of Plugging Contractor Terrel Drilling and Producing
Address Box 606, Russell, Kansas

STATE OF KANSAS COUNTY OF RUSSELL, ss.
Joe K. Branum (owner or operator) of the above-described

well, being first duly sworn on oath, says: That I have knowledge of the facts, statements, and matters herein contained and the log of the above-described well as filed and that the same are true and correct. So help me God.

(Signature) Joe K. Branum
Russell, Kansas
(Address)

SUBSCRIBED AND SWORN to before me this 15th day of August, 19 64

Mary Ann Branum
Notary Public.

My commission expires 11-13-67

AUG 20 1964

CONSERVATION DIVISION
Wichita, Kansas

W E L L L O G

OPERATOR: March Drilling Company
531 Petroleum Bldg.
Wichita, Kansas

CONTRACTOR: Terrel Drilling and Producing
Box 606
Russell, Kansas

LEASE: Owen #1

COMMENCED: August 2, 1964

LOCATION: NE NW, Sec. 7-24S-14W
Stafford County, Kansas

COMPLETED: August 14, 1964

DEPTHS & FORMATIONS

Surface Sand & Clay	40	Shale & Lime	1740
Sand & Gravel	155	Lime & Shale	2414
Shale	210	Shale & Lime	2610
Shale & Red Bed	495	Lime & Shale	2855
Red Bed	930	Shale & Lime	2991
Anhydrite	950	Lime & Shale	3742
Shale & Shells	1420	Shale & Lime	4170
Shale w/ lime streaks	1480	Sandy Lime & Shale (R.T.D.)	4255


STATE OF KANSAS)
)
COUNTY OF RUSSELL) ss...

Joe K. Branum, owner of Terrel Drilling and Producing, being first duly sworn on oath says: "That I have knowledge of the facts, statements and matters herein contained and the log of the above described well as filed and that the same are true and correct."



Joe K. Branum - TERREL DRILLING AND PRODUCING

Subscribed and sworn before me this 14th day of August, 1964.



Notary Public

My Commission Expires November 13, 1967.