

STATE OF KANSAS
STATE CORPORATION COMMISSION

WELL PLUGGING RECORD


OR
FORMATION PLUGGING RECORD

Strike out upper line when reporting plugging off formations.

Give All Information Completely
Make Required Affidavit
Mail or Deliver Report to:
Conservation Division
State Corporation Commission
800 Bittling Building
Wichita, Kansas

Stafford County. Sec. 12 Twp. 24 Rge. (E) 14 (W)

Location as "NE $\frac{1}{4}$ NW $\frac{1}{4}$ SW $\frac{1}{4}$ " or footage from lines NW SE SW
Lease Owner: Cities Service Oil Company
Lease Name: Shell "B" Well No. 2
Office Address: Bartlesville, Oklahoma
Character of Well (completed as Oil, Gas or Dry Hole): Dry Hole
Date well completed: August 20 19 50
Application for plugging filed: August 20 19 50
Application for plugging approved: August 20 19 50
Plugging commenced: August 20 19 50
Plugging completed: August 20 19 50
Reason for abandonment of well or producing formation: Dry Hole

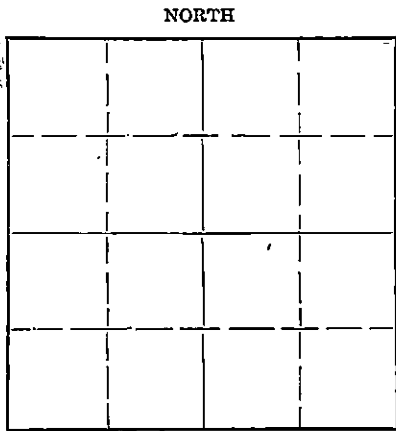

Locate well correctly on above Section Plat

If a producing well is abandoned, date of last production: 19.....
Was permission obtained from the Conservation Division or its agents before plugging was commenced?: Yes

Name of Conservation Agent who supervised plugging of this well: C. D. Stough
Producing formation: Kansas City Depth to top: 3598' Bottom: 3887' Total Depth of Well: 3887 Feet
Show depth and thickness of all water, oil and gas formations.

OIL, GAS OR WATER RECORDS

CASING RECORD

Formation	Content	From	To	Size	Put In	Pulled Out
				8-5/8"	375'	None

Describe in detail the manner in which the well was plugged, indicating where the mud fluid was placed and the method or methods used in introducing it into the hole. If cement or other plugs were used, state the character of same and depth placed, from.....feet to.....feet for each plug set.

3887' to 360' heavy mud.
360' to 315' wood plug and 15 sacks cement.
315' to 35' mud and soil.
35' to base of cellar, 10 sacks cement.

Rec'd

9-12-50
C. D. STOUGH

(If additional description is necessary, use BACK of this sheet)

Correspondence regarding this well should be addressed to: R. C. Cooper
Address: Box 751
Great Bend, Kansas

STATE OF Kansas, COUNTY OF Barton, ss.
V. M. Conover (employee of owner) or former employee of the above-described well,

being first duly sworn on oath, says: That I have knowledge of the facts, statements, and matters herein contained and the log of the above-described well as filed and that the same are true and correct. So help me God.

(Signature) V M Conover
Box 751, Great Bend, Kansas (Address)

SUBSCRIBED AND SWORN to before me this 29th day of August, 19 50

Phyllis C. Beckwith
Notary Public

My commission expires March 31, 1954.

PLUGGING
FILE SEC 12 T 24 R 14W
BOOK PAGE 22 LINE 57

WELL RECORD

Company Cities Service Oil Co. Well No. 2 Farm Shell "B"
 Location 990' North and 990' West of 3/4 Corner Sec. 12 T. 24 R. 14W
 Elevation 1917 (1914 Gr.) County Stafford State Kansas
 Drlg. Comm. August 9, 1950 Contractor Helm Drilling Company
 Drlg. Comp. August 20, 1950 Acid None
 T. D. 3887' Initial Prod. None - Dry Hole; P. & A. 6-20-50

CASING RECORD:

8-5/8" @ 368' cen. 250 wt cement

FORMATION RECORD:

surface soil & shale	0-90
shale & shells	350
red bed	800
anhydrite	830
shells & shale	1110
shale & shells	1775
lime & shale	1960
broken lime	2060
lime	2185
shale	2235
lime & shale	2580
shale	2775
lime & shale	2925
shale & lime	3255
lime & shale	3610
lime	3887 T. D.

Top Lansing	3598'
Base Kansas City	3870'
Total Depth	3887'

Drill stem test 3715-3730 recovered
 7' slightly oil and gas cut mud in
 30 mins., BHP zero.

Drill stem test 3751-3772 recovered
 66' salt water, no oil, in 30 mins.,
 BHP 840#.

Drill stem test 3794-3801 recovered
 30' salt water with few spots oil in
 30 mins., BHP zero.

STFG: 500' 0°
 1000' 0°
 1500' 1°
 2000' 1°
 2500' 1°
 3000' 2°

PLUGGING

FILE SEC 12 T. 24 R. 14W

BOOK PAGE 22 LINE 38