


Give All Information Completely
Make Required Affidavit
Mail or Deliver Report to:
Conservation Division
State Corporation Commission
211 No. Broadway
Wichita, Kansas

WELL PLUGGING RECORD

NORTH

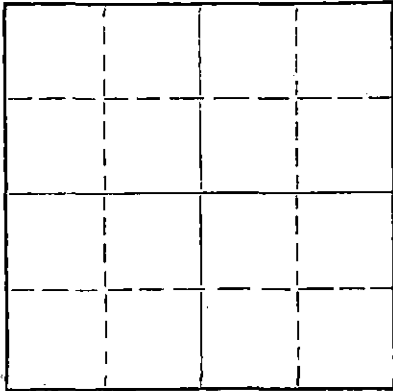

Locate well correctly on above
Section Plat

Pratt County. Sec. 15 Twp. 29S Rge. 14 (E) 14 (W)
Location as "NE/CNW%SW%" or footage from lines C NW SW
Lease Owner Rains & Williamson Oil Company
Lease Name Luther Well No. 1
Office Address 1425 Wichita Plaza Bldg., Wichita, Kansas
Character of Well (completed as Oil, Gas or Dry Hole) Dry Hole
Date well completed 3-11 19 66
Application for plugging filed 3-11 19 66
Application for plugging approved 3-11 19 66
Plugging commenced 3-11 19 66
Plugging completed 3-11 19 66
Reason for abandonment of well or producing formation no oil or gas found
in commercial quantities
If a producing well is abandoned, date of last production _____ 19 ____
Was permission obtained from the Conservation Division or its agents before plugging was commenced? yes

Name of Conservation Agent who supervised plugging of this well Archie Elving, Pratt, Kansas
Producing formation _____ Depth to top _____ Bottom _____ Total Depth of Well 4610 Feet
Show depth and thickness of all water, oil and gas formations.

OIL, GAS OR WATER RECORDS

CASING RECORD

FORMATION	CONTENT	FROM	TO	SIZE	PUT IN	PULLED OUT
				8-5/8"	431.38	

Describe in detail the manner in which the well was plugged, indicating where the mud fluid was placed and the method or methods used in introducing it into the hole. If cement or other plugs were used, state the character of same and depth placed, from _____ feet to _____ feet for each plug set.

Mudded upto 300'. Set solid bridge, cement with 25 sacks. Went back to 40', set solid bridge and capped with 10 sacks. Plugging completed 5:00 A.M. 3-11-66.

RECEIVED
STATE CORPORATION COMMISSION
MAR 16 1966
CONSERVATION DIVISION
Wichita, Kansas

(If additional description is necessary, use BACK of this sheet)

Name of Plugging Contractor Rains & Williamson Oil Company
Address 1425 Wichita Plaza, Wichita, Kansas

STATE OF Kansas, COUNTY OF Sedgwick, ss.
Wilson Rains (employee of owner) or (owner or operator) of the above-described well, being first duly sworn on oath, says: That I have knowledge of the facts, statements, and matters herein contained and the log of the above-described well as filed and that the same are true and correct. So help me God.

(Signature) Wilson Rains
Wilson Rains, Partner
1425 Wichita Plaza, Wichita, Kansas
(Address)

SUBSCRIBED AND SWORN to before me this 15 day of March, 19 66

My commission expires January 8, 1968

Shirley Keck
Notary Public.

ROTARY DRILLING LOG

OPERATOR: Rains & Williamson Oil Co.
and Sam P. Wallingford
#1 Luther
C NW SW Section 15-29S-14W
Pratt County, Kansas

CONTRACTOR: Rains & Williamson Oil Co.
Commenced: 2-23-66
Completed 3-11-66
Remarks: Set 431.38 of 8-5/8"
surface pipe with 250
sacks GL3.

FORMATIONS:

Sand	235'
Red Bed	430'
Red Bed Shells & Shale	700'
Shale w/Shells	838'
Anhydrite	865'
Shale & Shells	1830'
Shale & Lime	2117'
Lime w/Shale	2260'
Lime	2570'
Lime w/Shale	2940'
Shale & Lime	3645'
Lime w/Shale	3735'
Lime	3920'
Lime w/Shale	3975'
Lime	4425'
Lime Cherty	4590'
Lime	4595'
Simpson Sand	4600'
Sand & Lime	4610'
RDT (D & A)	4610'

RECEIVED
STATE CORPORATION COMMISSION
MAR 16 1966
CONSERVATION DIVISION
Topeka, Kansas

We certify the above log is true and correct to the best of our knowledge and belief.

RAINS & WILLIAMSON OIL CO.

Wilson Rains
Wilson Rains, Partner

Subscribed and sworn to before me, a Notary Public in and for the State of Kansas, County of Sedgwick, this 15th day of March, 1966.

My Commission Expires January 8, 1968

Shirley Keck
Shirley Keck, Notary Public