

15-155-00310-0000


STATE OF KANSAS
STATE CORPORATION COMMISSION

WELL PLUGGING RECORD

Give All Information Completely
Make Required Affidavit
Mail or Deliver Report to:
Conservation Division
State Corporation Commission
800 Biting Building
Wichita, Kansas

Reno County, Sec. 4 Twp. 22 Rge. 10 (E) (W)
S.E., E., S.E.

Location as "NE/CNW $\frac{1}{4}$ /SW $\frac{1}{4}$ " or footage from lines
Lease Owner Bud Edwards Drilling Co.
Lease Name Titus Well No. 1
Office Address 510 Petroleum Building, Wichita, Kansas
Character of Well (completed as Oil, Gas or Dry Hole) Dry Hole
Date well completed March 25 1952
Application for plugging filed March 25 1952
Application for plugging approved March 27, 1952
Plugging commenced March 26 1952
Plugging completed March 26 1952
Reason for abandonment of well or producing formation Dry Hole

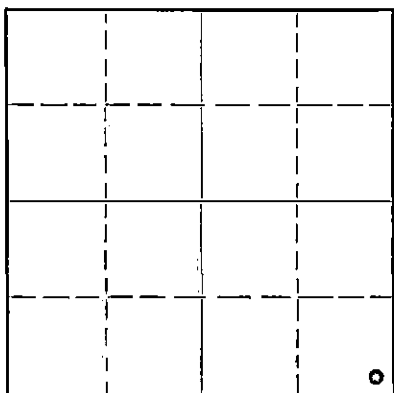

Locate well correctly on above
Section Plat

If a producing well is abandoned, date of last production 19
Was permission obtained from the Conservation Division or its agents before plugging was commenced? Yes

Name of Conservation Agent who supervised plugging of this well Ruell Durkee
Producing formation Depth to top Bottom Total Depth of Well 3583 Feet
Show depth and thickness of all water, oil and gas formations.

OIL, GAS OR WATER RECORDS

CASING RECORD

Formation	Content	From	To	Size	Put In	Pulled Out
Lansing - K.C.	0	3111'	3453'	8 5/8"	240'	None
Conglomerate	0	3453'	3489'			
Simpson	0	3489'	3553'			
Arbuckle	0	3553'	3583'	T.D.		

Describe in detail the manner in which the well was plugged, indicating where the mud fluid was placed and the method or methods used in introducing it into the hole. If cement or other plugs were used, state the character of same and depth placed, from feet to feet for each plug set.

From 3583' to 240' Filled hole with heavy mud. Halliburton Plug @ 240'
15 Sks. of Cement on top of Halliburton Plug - Top of Cement 180' to 25' Heavy Mud
Halliburton Plug @ 25' 5 Sks. of Cement on top of Halliburton Plug Cement fill up
to surface

4-10-52

APR 10 1952

(If additional description is necessary, use BACK of this sheet)

Name of Plugging Contractor Bud Edwards Drilling Company
Address 510 Petroleum Building, Wichita 2, Kansas

STATE OF KANSAS, COUNTY OF SEDGWICK, ss.
Bud Edwards

(owner or operator) of the above-described well,
being first duly sworn on oath, says: That I have knowledge of the facts, statements, and matters herein contained and the log of the above-described well as filed and that the same are true and correct. So help me God.

(Signature) [Signature] 510 Petroleum Bldg., Wichita, Kansas
(Address)

SUBSCRIBED AND SWORN to before me this 10th day of April, 1952
[Signature]

My commission expires My Commission Expires Jan. 31, 1953 Notary Public.

PLUGGING
FILE SEC 4 T W R 104
BOOK PAGE 3 LINE 10

March 25, 1952

Well Log

Titus Well # 1 , Reno County, Kansas
S.E., E., S.E., Sec.4, Twp.22 Rge.10W

For Drillers Well Log -

Commenced Drilling
3/10/52
Completed Drilling
3/25/52

0'	225'	Surface Sand
225'	240'	Lime
240'	1450'	Shale w/ Lime Brks.
1450'	2680'	Lime w/ Shale Brks.
2680'	2690'	Shale
2690'	3474'	Lime
3474'	3477'	Lime & Chert
3477'	3583'	Lime

Geologist Tops -

Elevation - D.F. 1751'
" Ground 1749'

Lansing K.C. 3111'
Conglomerate 3453'
Simpson 3489'
Arbuckle 3553'
T.D. 3583'

4-10-52
STAT
APR 10 1952

No Commercial Shows, Recommended Plugging By -
T.M. Roberts - Geologist in charge.

This is to certify that the above is a correct copy of the Drillers' log
of the above described well.

BUD EDWARDS DRILLING CO.

Bud Edwards
Owner

Sedgwick County)
State of Kansas) SS

PLUGGING
FLR SEC 4 T 2 V R 10 W
BOOK PAGE 3 LINE 40

Subscribed to and sworn before me this 10 day of April, 1952.

W. G. Steward Notary Public

My commission expires Feb. 25, 1952