


15-155-00144-0000

STATE OF KANSAS  
STATE CORPORATION COMMISSION

Give All Information Completely  
Make Required Affidavit  
Mail or Deliver Report to:  
Conservation Division  
State Corporation Commission  
800 Bitting Building  
Wichita, Kansas

WELL PLUGGING RECORD

NORTH

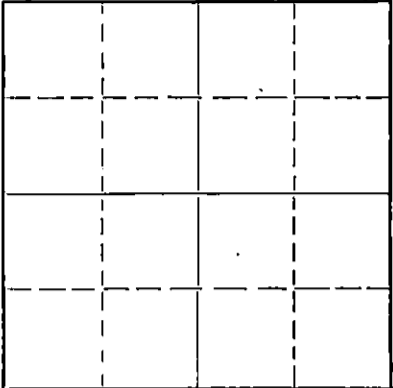

Locate well correctly on above Section Plat

~~XXXXXXSW~~ Reno County, Sec. 8 Twp 22 Rge. 10 (E) W (W)  
Location as "NE/CNW/SW" or footage from lines So So SW  
Lease Owner Dozier Oil Company,  
Lease Name Newell Well No. 1  
Office Address Union National Bank Building, Wichita, Kansas  
Character of Well (completed as Oil, Gas or Dry Hole) Dry Hole  
Date well completed 12-6-53 19  
Application for plugging filed 12-6-53 19  
Application for plugging approved 12-6-53 19  
Plugging commenced 12-6-53 19  
Plugging completed 12-6-53 19  
Reason for abandonment of well or producing formation \_\_\_\_\_

If a producing well is abandoned, date of last production \_\_\_\_\_ 19  
Was permission obtained from the Conservation Division or its agents before plugging was commenced? Yes

Name of Conservation Agent who supervised plugging of this well Ruel Durkee  
Producing formation \_\_\_\_\_ Depth to top \_\_\_\_\_ Bottom \_\_\_\_\_ Total Depth of Well 3635 Feet  
Show depth and thickness of all water, oil and gas formations.

OIL, GAS OR WATER RECORDS

CASING RECORD

FORMATION	CONTENT	FROM	TO	SIZE	PUT IN	PULLED OUT
		0	291	8 5/8"		

Describe in detail the manner in which the well was plugged, indicating where the mud fluid was placed and the method or methods used in introducing it into the hole. If cement or other plugs were used, state the character of same and depth placed, from 275 feet to 30 feet for each plug set.

Used two Halliburton plugs. Pushed first plug to the depth of 275 Feet cemented with 15-sacks cement, cemented through drill pipe. Push plug #2 to the depth of 30 Feet cemented with 5-sacks cement.

12-11-53

(If additional description is necessary, use BACK of this sheet)  
Name of Plugging Contractor Stag Drilling Inc.,  
Address Box 169, Chase, Kansas.

STATE OF Kansas, COUNTY OF Rice, ss.  
C.L. Tyrrell (employee of owner) or (owner or operator) of the above-described well, being first duly sworn on oath, says: That I have knowledge of the facts, statements, and matters herein contained and the log of the above-described well as filed and that the same are true and correct. So help me God:

(Signature) C. L. Tyrrell


(Address)

SUBSCRIBED AND SWORN TO before me this 9th day of December, 19 53

Orlando Miller

Notary Public.

My commission expires 3-1-55

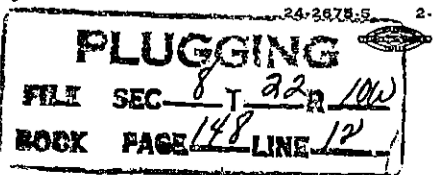

15-155-00144-0000

CONTRACTOR'S WELL LOG

Operator Dozier Oil Co. Farm name Newell Well No. 1  
LOCATION SE SE SW Sec. 8-22-10W COUNTY Reno STATE Kansas  
Commencement Date 11-23-53 Completion Date 12-6-53

Log of Well

From	To	Formation	Deviation from Vertical	Remarks
0	291	Surface soil		
291	430	Shale Shells		
430	446	Anhydrite		
446	970	Shale Shells	10" -500'	
970	1180	Salt		
1180	1380	Shale lime		
1380	1480	Lime sand shale		
1480	2080	Lime shale		
2080	2410	Shale shells		
2410	2590	Shale lime		
2590	2891	lime		
2891	2922	lime shale		
2922	2986	lime		
2986	2991	shale		
2991	3015	lime		
3015	3124	lime shale		
3124	3430	lime		
3430	3495	lime shale		
3495	3545	lime shale chert		
3545	3598	shale sandy		
3598	3635	Arbuckle		Total depth dry hole

Set 291' (.15 jts) 8 5/8" casing

STATE OF KANSAS)  
SS.  
COUNTY OF RICE)

The undersigned certifies that to the best of his knowledge and belief the above facts are true and correct.

12-11-53

Stag Drilling Inc.,

By: C. S. Purcell  
President

Subscribed and sworn to before me this 9th day of December, 1953

My Commission Expires 3/1/55

Orlando Miller  
Notary Public.

PLUGGING  
FILE SEC. 8-22-10W  
