


WELL PLUGGING RECORD

Give All Information Completely
Make Required Affidavit
Mail or Deliver Report to:
Conservation Division
State Corporation Commission
211 No. Broadway
Wichita, Kansas

RENO County. Sec. 10 Twp. 22S Rge. (E) 10 (W)

Location as "NE/CNW/SW" or footage from lines NE NE NE
Lease Owner REX & MORRIS DRILLING COMPANY AND E. H. RIGGS
Lease Name MILLER Well No. 1
Office Address P. O. BOX 334, EL DORADO, KANSAS
Character of Well (completed as Oil, Gas or Dry Hole) DRY HOLE
Date well completed 28 MAY 19 63
Application for plugging filed 28 MAY 19 63
Application for plugging approved 28 MAY 19 63
Plugging commenced 28 MAY 19 63
Plugging completed 28 MAY 19 63
Reason for abandonment of well or producing formation DRY HOLE

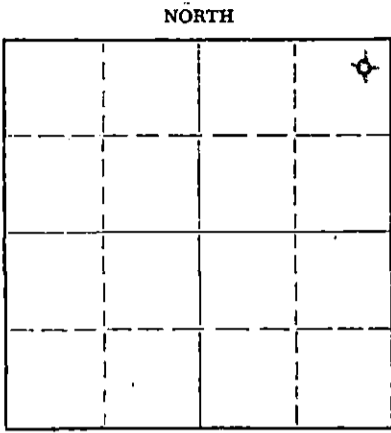

Locate well correctly on above
Section Plat

If a producing well is abandoned, date of last production NONE 19__
Was permission obtained from the Conservation Division or its agents before plugging was commenced? YES

Name of Conservation Agent who supervised plugging of this well GILBERT J. TOMAN
Producing formation NONE Depth to top _____ Bottom _____ Total Depth of Well 3610 Feet
Show depth and thickness of all water, oil and gas formations.

OIL, GAS OR WATER RECORDS

CASING RECORD

FORMATION	CONTENT	FROM	TO	SIZE	PUT IN	PULLED OUT
SURFACE HOLE	WATER	SURFACE	218'RB	8 5/8"OD	212.84'	LEFT IN
(SEE ATTACHED LOG)						

Describe in detail the manner in which the well was plugged, indicating where the mud fluid was placed and the method or methods used in introducing it into the hole. If cement or other plugs were used, state the character of same and depth placed, from _____ feet to _____ feet for each plug set.

FILLED HOLE WITH DRILLING MUD TO 200', SET PLUG AND CEMENTED WITH 20 SACKS CEMENT, FILLED HOLE WITH DRILLING MUD TO 35', SET PLUG AND CEMENTED WITH 10 SACKS CEMENT, PUT 2 SACKS CEMENT IN RAT HOLE.

RECEIVED
STATE CORPORATION COMMISSION

OCT 22 1963
10 22-63
CONSERVATION DIVISION
Wichita, Kansas

(If additional description is necessary, use BACK of this sheet)
Name of Plugging Contractor REX & MORRIS DRILLING COMPANY
Address P. O. BOX 334, EL DORADO, KANSAS

STATE OF KANSAS, COUNTY OF BUTLER, ss.
A. H. FISHER (employee of owner) or (owner or operator) of the above-described well, being first duly sworn on oath, says: That I have knowledge of the facts, statements, and matters herein contained and the log of the above-described well as filed and that the same are true and correct. So help me God.

(Signature) [Signature]
P. O. BOX 334, EL DORADO, KANSAS
(Address)

SUBSCRIBED AND SWORN to before me this 6TH day of JUNE 19 63
Mary Bailey
MARY BAILEY Notary Public.

My commission expires 28 JULY 1963

15-155-02008-0000
Elevation 1744 RB
1741 DF

MILLER # 1

Rex & Morris Drilling Co. and E.H. Riggs

Total Depth:	3610	Location:	NE NE NE
Contractor:	Rex & Morris	Section:	10-22S-10W
Commenced:	5-22-63	County:	Reno County, Kansas
Completed:	5-28-63	Casing Record:	
Initial Prod.:	D. & A.		8 5/8 @ 218' w/210 sacks

<u>FORMATION</u>	<u>DEPTH</u>
Surface Hole	218
Shale	383
Anhydrite	392
Shale	1280
Lime and Shale	2060
Shale and Lime	2400
Lime and Shale	2670
Lime	2820
Lime and Shale	3106
Lime	3396
Lime and Shale	3465
Chert	3490
Shale and Sand	3556
Lime (Arbuckle)	3610

RECEIVED
STATE CORPORATION COMMISSION
OCT 22 1963
CONSERVATION DIVISION
Wichita, Kansas

I hereby certify the foregoing statements are true and correct to the best of my knowledge and belief.

Rex & Morris Drilling Company

By Paul D. Koontz
Paul D. Koontz, Geologist

STATE OF KANSAS
COUNTY OF BUTLER, SS.

Subscribed and sworn to before me, a Notary Public, this 31st day of May, 1963.

Elizabeth Deschner
Elizabeth Deschner, Notary Public

My commission expires: August 8, 1966.