

STATE OF KANSAS
STATE CORPORATION COMMISSION

15-155-20259-0000

WELL PLUGGING RECORD

Give All Information Completely
Make Required Affidavit
Mail or Deliver Report to
Conservation Division
State Corporation Comm.
245 North Water
Wichita, KS 67202

Reno County, Sec. 12 Twp. 22 Rge. 10 NE/W
Location as "NE/CNW/SW" or footage from lines
NE/NW/NE


Lease Owner Shields Oil Producers, Inc.
Lease Name Proffitt Well No. 1
Office Address Shields Building, Russell, KS 67665
Character of Well (Completed as Oil, Gas or Dry Hole)
Oil

Date Well completed 19
Application for plugging filed 19
Application for plugging approved 19
Plugging commenced July 12 1978
Plugging completed July 27 1978
Reason for abandonment of well or producing formation

Depleted
If a producing well is abandoned, date of last production 19

Was permission obtained from the Conservation Division or its agents before plugging was commenced? Yes

Name of Conservation Agent who supervised plugging of this well Gilbert Toman
Producing formation Depth to top Bottom Total Depth of Well 3625'
Show depth and thickness of all water, oil and gas formations.

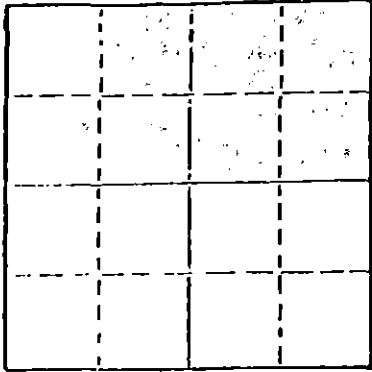

Locate well correctly on above Section Plot

OIL, GAS OR WATER RECORDS 8-3-78

CASING RECORD

DATE	CONTENT	FROM	TO	SIZE	PUT IN	PULLED OUT
AUG 03 1978				8 5/8"	205'	NONE
				5 1/2"	3197	2548.60'

Describe in detail the manner in which the well was plugged, indicating where the mud fluid was placed and the method or methods used in introducing it into the hold. If cement or other plugs were used, state the character of same and depth placed, from feet to feet for each plug set.

Dumped sand to 3100' and five (5) sacks cement.
Shot pipe at 2600' and 2590'.
Spotted oil behind casing
Pulled 79 joints of 5 1/2" casing
Plugged hole with four (4) sacks hulls, 25 gel, 100 sacks 50/50 poz with 4% added gel

(If additional description is necessary, use BACK of this sheet)

Name of Plugging Contractor Rockhold Engineering, Inc.

STATE OF Kansas COUNTY OF Barton, ss.
James W. Rockhold (employee of owner) or (owner or operator)
of the above-described well, being first duly sworn on oath, says: That I have knowledge of the facts, statements, and matters herein contained and the log of the above-described well as filed and that the same are true and correct. So help me God.

(Signature) James W. Rockhold
James W. Rockhold Box 698, Great Bend, KS
(Address) 67530

SUBSCRIBED AND SWORN TO before me this 22nd day of August, 1978

STATE NOTARY PUBLIC
CATHY L. COLE
Barton County, Kansas
My Appt. Exp. June 14, 1982

Cathy L. Cole
Notary Public.

My commission expires



Shields


15-155-20259-0000

Russell, Kansas

WELL LOG

Operator: Shields Oil Producers, Inc.
 Well: Profit #1
 Commenced: March 25, 1975
 Completed: April 4, 1975
 Contractor: Shields Drilling Co., Inc.

Well Description: NE NW NF
 Sec. 12-22S-10W
 Reno Co., Kansas

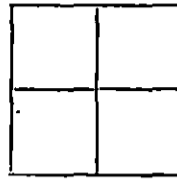

Elevation: 1,755' RB

Treatment:

Production:

CASING RECORD

Size	Run	Pulled
8 5/8"	205'	Cmtd. w/225 sax
5 1/2"	3,197'	Cmtd. w/75 sax

Tops: Heebner 2,926'
 Toronto 2,946'
 Lansing -KC 3,092'
 Viola 3,418'
 Simpson Sand 3,572'
 Arbuckle 3,614'

..... Figures Indicate Bottom of Formations

Sand	135'
Shale	205'
Shale & redbed	580'
Shale	1,240'
Shale & lime	3,145'
Lime	3,390'
Lime & shale	3,568'
Lime	3,625' RTD

4-13-78

STATE OF KANSAS
 APR 13 1978

