


STATE OF KANSAS
STATE CORPORATION COMMISSION

WELL PLUGGING RECORD

Give All Information Completely
Make Required Affidavit
Mail or Deliver Report to
Conservation Division
State Corporation Comm.
245 North Water
Wichita, KS 67202

Reno County, Sec. 12 Twp. 22S Rge. 10W E/W
Location as "NE/CNW $\frac{1}{4}$ /SW $\frac{1}{4}$ " or footage from lines
C NW SE

Lease Owner Shields Oil Producers, Inc.
Lease Name Brown "C" #1 Well No. 1
Office Address P. O. Box 709, Russell, Kansas 67665
Character of Well (Completed as Oil, Gas or Dry Hole)
Dry Hole

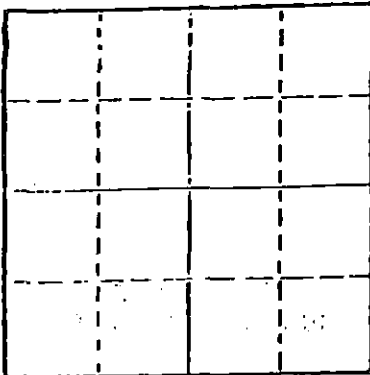

Locate well correctly on above
Section Plot

Date Well completed April 28, 1977 19
Application for plugging filed April 28, 1977 19
Application for plugging approved April 28, 1977 19
Plugging commenced 7:30 PM, April 28, 1977 19
Plugging completed 9:00 PM, April 28, 1977 19
Reason for abandonment of well or producing formation
Dry Hole

If a producing well is abandoned, date of last production 19

Was permission obtained from the Conservation Division or
its agents before plugging was commenced? Yes

Name of Conservation Agent who supervised plugging of this well Gilbert Toman
Producing formation Depth to top Bottom Total Depth of Well 3190'
Show depth and thickness of all water, oil and gas formations.

OIL, GAS OR WATER RECORDS

CASING RECORD

FORMATION	CONTENT	FROM	TO	SIZE	PUT IN	PULLED OUT
				8 5/8"	232'	None

Describe in detail the manner in which the well was plugged, indicating where the mud fluid was placed and the method or methods used in introducing it into the hold. If cement or other plugs were used, state the character of same and depth placed, from feet to feet for each plug set.

Filled hole with heavy mud.
40 sacks at 500';
25 sacks at 200';
Solid Bridge and 10 sacks at 40'
with 1/2 sack hulls;
2 sacks in rathole.

RECEIVED
STATE CORPORATION COMMISSION
MAY 03 1977
5-3-77
CONSERVATION DIVISION
Wichita, Kansas

(If additional description is necessary, use BACK of this sheet)

Name of Plugging Contractor Sterling Drilling Company

STATE OF KANSAS COUNTY OF RICE, ss.
F. A. Wuellner (employee of owner) or (owner or operator)
of the above-described well, being first duly sworn on oath, says: That I have knowledge of the facts, statements, and matters herein contained and the log of the above-described well as filed and that the same are true and correct. So help me God. STERLING DRILLING COMPANY

(Signature) F. A. Wuellner
F. A. Wuellner, Secretary
P. O. Box 129, Sterling, Kansas 67579
(Address)

SUBSCRIBED AND SWORN TO before me this 29th day of April, 1977

Bernard Laudermilk
Bernard Laudermilk, Notary Public.

My commission expires

STERLING DRILLING COMPANY
P. O. Box 129
Sterling, Kansas 67579

WELL LOG ----- BROWN "C" #1
Located: C-NW SE, Section 12-22S-10W, Reno County,
Kansas.

OWNER: Shields Oil Producers, Inc.
ROTARY DRILLING CONTRACTOR: Sterling Drilling Company

COMMENCED: April 23, 1977
COMPLETED: April 28, 1977

TOTAL DEPTH: 3190'

<u>LOG</u>	<u>CASING RECORD</u>
0 - 235 Gravel and Shale	Ran 220' 8 5/8" casing, cemented at 232' K.B. with 200 sacks 60/40 Pozmix, 3% cc. Plug down at 8:30 PM, 4-23-77.
235 - 1110 Red Bed, Shale	
1110 - 1511 Shale	
1511 - 2165 Lime and shale	
2165 - 3190 Lime	Plugged.

RECEIVED
STATE CORPORATION COMMISSION
MAY 03 1977
CONSERVATION DIVISION
Wichita, Kansas