


STATE OF KANSAS
STATE CORPORATION COMMISSION

WELL PLUGGING RECORD

Give All Information Completely
Make Required Affidavit
Mail or Deliver Report to:
Conservation Division
State Corporation Commission
800 Bittling Building
Wichita, Kansas

Reno County, Sec. 13 Twp. 22S Rge. 10 (X) (W)
Location as "NE/CNW/SW" or footage from lines SE NW SE
Lease Owner Dudley and Heath Drilling Company
Lease Name Creighton Well No. 1
Office Address Cushing, Oklahoma
Character of Well (completed as Oil, Gas or Dry Hole) Dry Hole
Date well completed March 16, 19 55
Application for plugging filed March 16, 19 55
Application for plugging approved March 16, 19 55
Plugging commenced March 16, 19 55
Plugging completed March 16, 19 55
Reason for abandonment of well or producing formation Dry

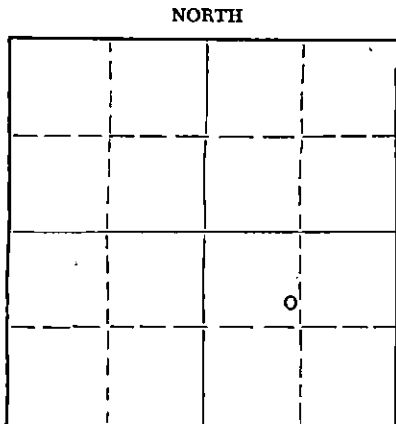

Locate well correctly on above
Section Plat

If a producing well is abandoned, date of last production 19
Was permission obtained from the Conservation Division or its agents before plugging was commenced? yes

Name of Conservation Agent who supervised plugging of this well
Producing formation Depth to top Bottom Total Depth of Well 3756' Feet
Show depth and thickness of all water, oil and gas formations.

OIL, GAS OR WATER RECORDS

CASING RECORD

FORMATION	CONTENT	FROM	TO	SIZE	PUT IN	PULLED OUT
		0	250'	8 5/8"	250'	0

Describe in detail the manner in which the well was plugged, indicating where the mud fluid was placed and the method or methods used in introducing it into the hole. If cement or other plugs were used, state the character of same and depth placed, from feet to feet for each plug set.

From 3756' back to 250' with heavy rotary mud. One plug set at 250' with 15 sacks cement placed through drill pipe. From 250' back to 45' of D. F., with heavy mud, top plug wired and five sacks cement.

(If additional description is necessary, use BACK of this sheet)

Name of Plugging Contractor Buick Drilling Inc.
Address P. O. Box 331, St. John, Kansas


STATE OF Kansas, COUNTY OF Stafford, ss.
H. R. Buick (employee of owner) or (owner or operator) of the above-described well, being first duly sworn on oath, says: That I have knowledge of the facts, statements, and matters herein contained and the log of the above-described well as filed and that the same are true and correct. So help me God.

(Signature) *H. R. Buick*
P. O. Box 331, St. John, Kansas
(Address)

SUBSCRIBED AND SWORN TO before me this 17th day of March, 19 55

Roberta Shogren
Notary Public.

My commission expires December 26, 1955

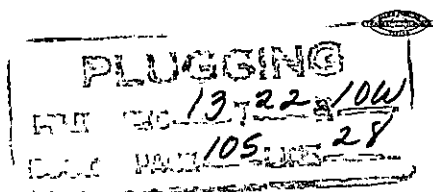

3-23-55

DRILLERS LOG

Creighton #1	SE NW SE Sec. 13-22S-10W
Commenced R.D.: 3-1-55	Reno County, Kansas
Completed R.D.: 3-15-55	Elevation: 1745 D.F.
Total Depth: 3756'	Initial Prod.: None
Casing Record: 250' of 8 5/8"	Contractor: Buick Drilling Inc.

STRATA	DEPTH
Sand	0 - 10
Clay	10 - 25
Sand, clay and gravel	25 - 129
Gravel	129 - 170
Sandy red bed	170 - 200
Red bed	200 - 250
Red bed, shale and shells	250 - 500
Anhydrite	500 - 520
Shale and shells	520 - 1160
Salt and shale	1160 - 1240
Shale and shells	1240 - 1280
Lime	1280 - 1390
Lime and shale	1390 - 3138
Lime	3138 - 3190
Lime and shale	3190 - 3225
Lime	3225 - 3300
Lime and shale	3300 - 3345
Lime	3345 - 3395
Lime and shale	3395 - 3580
Lime, shale and chert	3580 - 3610
Chert and shale	3610 - 3635
Lime and shale	3635 - 3647
Sand and shale	3647 - 3675
Lime and shale	3675 - 3724
Lime	3724 - 3736
Lime and shale	3736 - 3756 T.D.

I hereby certify the above a true and correct drilling log as reflected by the drilling reports of the Buick Drilling Inc.

BUICK DRILLING INC.

H. R. Buick
H. R. Buick, President

Signed and sworn to in my presence this 16th day of March, 1955, by H.R. Buick, President of the Buick Drilling Inc.

Roberta Shogren
Notary Public

My commission expires December 26, 1955.

PLUGGING
MAR 23 1955
PAGE 105 LINS 28

3-23-55
RECEIVED
CONSERVATION COMMISSION
MAR 23 1955
CONSERVATION DIVISION
Wichita, Kansas