


STATE OF KANSAS  
STATE CORPORATION COMMISSION

WELL PLUGGING RECORD

Give All Information Completely  
Make Required Affidavit  
Mail or Deliver Report to  
Conservation Division  
State Corporation Comm.  
245 North Water  
Wichita, KS 67202

Reno County. Sec. 13 Twp. 22S Rge. 10W E/W  
Location as "NE/CNW $\frac{1}{2}$ SW $\frac{1}{2}$ " or footage from lines  
NE NE NW

Lease Owner Kelso Casing Pulling  
Lease Name Sanky "A" #1 Well No. \_\_\_\_\_  
Office Address Box 176, Chase, Kansas 67524  
Character of Well (Completed as Oil, Gas or Dry Hole) \_\_\_\_\_

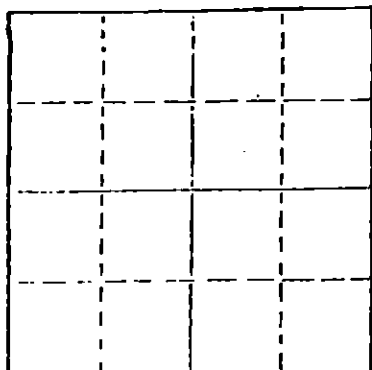

Locate well correctly on above  
Section Plat

Date Well completed \_\_\_\_\_ 19\_\_\_\_  
Application for plugging filed \_\_\_\_\_ 19\_\_\_\_  
Application for plugging approved \_\_\_\_\_ 19\_\_\_\_  
Plugging commenced 1/22/81 19\_\_\_\_  
Plugging completed 1/27/81 19\_\_\_\_  
Reason for abandonment of well or producing formation \_\_\_\_\_

Depleted  
If a producing well is abandoned, date of last production \_\_\_\_\_ 19\_\_\_\_

Was permission obtained from the Conservation Division or its agents before plugging was commenced? Yes

Name of Conservation Agent who supervised plugging of this well Gilbert Toman  
Producing formation \_\_\_\_\_ Depth to top \_\_\_\_\_ Bottom \_\_\_\_\_ Total Depth of Well 4435'  
Show depth and thickness of all water, oil and gas formations.

OIL, GAS OR WATER RECORDS

CASING RECORD

FORMATION	CONTENT	FROM	TO	SIZE	PUT IN	PULLED OUT
				8-5/8"	214	None
				5-1/2"	3750	2054'

Describe in detail the manner in which the well was plugged, indicating where the mud fluid was placed and the method or methods used in introducing it into the hold. If cement or other plugs were used, state the character of same and depth placed, from \_\_\_\_\_ feet to \_\_\_\_\_ feet for each plug set.

Plugged bottom at 3250, sanded to 3200 and ran 5 sacks cement. Made shots at 2802, 2607, 2408, 2215, 2130 and 2045. Pulled total of 61 joints. Bailed water to 200', set bridge and put 25 sacks cement on bottom of surface and 10 sacks cement on top. Plugging complete.

(If additional description is necessary, use BACK of this sheet) 2-5-81


Name of Plugging Contractor KELSO CASING PULLING  
CHASE, KANSAS FEB - 5 1981

STATE OF Kansas COUNTY OF Rice  
R. Darrell Kelso (employee of owner) or (owner or operator)  
of the above-described well, being first duly sworn on oath, says: That I have knowledge of the facts, statements, and matters herein contained and the log of the above-described well as filed and that the same are true and correct. So help me, God.

(Signature) R. Darrell Kelso  
Chase, Kansas (Address)

SUBSCRIBED AND SWORN TO before me this 4th day of February, 19 81

My commission expires \_\_\_\_\_

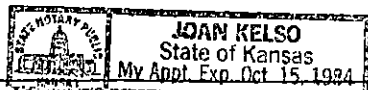

Joan Kelso  
Notary Public.