


STATE OF KANSAS
STATE CORPORATION COMMISSION

Give All Information Completely
Make Required Affidavit
Mail or Deliver Report to:
Conservation Division
State Corporation Commission
211 No. Broadway
Wichita, Kansas

WELL PLUGGING RECORD

NORTH

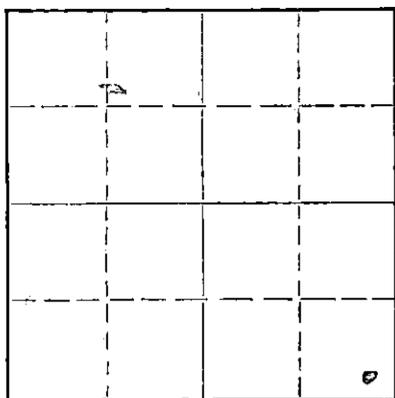

Locate well correctly on above
Section Plat

Reno County. Sec. 21 Twp. 22 Rge. 10 (W) W(W)
Location as "NE/CNW/SW" or footage from lines SE SE SE
Lease Owner The Duke Drilling Company
Lease Name SCHWEIZER Well No. 1
Office Address Box 823, Great Bend, Kansas
Character of Well (completed as Oil, Gas or Dry Hole) Dry Hole
Date well completed May 25, 1963 19 63
Application for plugging filed " 19 63
Application for plugging approved " 19 63
Plugging commenced May 25 19 63
Plugging completed " @ " 19 63
Reason for abandonment of well or producing formation _____

If a producing well is abandoned, date of last production _____ 19 _____
Was permission obtained from the Conservation Division or its agents before plugging was commenced? Yes

Name of Conservation Agent who supervised plugging of this well Mr. G.J. Toman
Producing formation _____ Depth to top _____ Bottom _____ Total Depth of Well 3685 Feet
Show depth and thickness of all water, oil and gas formations.

OIL, GAS OR WATER RECORDS

CASING RECORD

FORMATION	CONTENT	FROM	TO	SIZE	PUT IN	PULLED OUT

Describe in detail the manner in which the well was plugged, indicating where the mud fluid was placed and the method or methods used in introducing it into the hole. If cement or other plugs were used, state the character of same and depth placed, from _____ feet to _____ feet for each plug set.

Filled hole with heavy mud to 265'
Set wooden plug 1/4 sack hulls 20 sacks cement
Filled hole with heavy mud to 40' set wooden plug 1/4 sacks hulls,
& 10 sacks cement.
Plugged rat hole 2 sacks cement.

RECEIVED
STATE CORPORATION COMMISSION

MAY 29 1963
5-29-63
CONSERVATION DIVISION
Wichita, Kansas

(If additional description is necessary, use BACK of this sheet)

Name of Plugging Contractor Duke Drlg. Co.
Address Great Bend, Ks.

STATE OF KANSAS, COUNTY OF BARTON, ss.
L. O. Chubb (employee of owner) or (owner/representative) of the above-described well, being first duly sworn on oath, says: That I have knowledge of the facts, statements, and matters herein contained and the log of the above-described well as filed and that the same are true and correct. So help me God.

(Signature) *L. O. Chubb*
Box 823, Great Bend, Kansas
(Address)

SUBSCRIBED AND SWORN TO before me this 28th day of May, 19 63.

My commission expires June 24, 1963
Clair E. Stimson Notary Public.



W E L L L O G

Date Commenced: May 15, 1963
Date Completed: May 24, 1963

Duke Drilling Company
SCHWEIZER #1
SE SE SE of Sec. 21-22-10w
Reno County, Kansas

0	--	150'	Sand
150	--	172'	Red Shale
172	--	237'	Sand
237	--	271'	Red Bed
271	--	385'	Shale & Red Bed
385	--	420'	ANHYDRITE
420	--	1440'	Shale & Shells
1440	--	2735'	Lime & Shale
2735	--	3006'	Lime
3006	--	3010'	Shale
3010	--	3054'	Lime - Shale
3054	--	3147'	Sand-Shale
3147	--	3172'	Lime - Shale
3172	--	3548'	Lime
3548	--	3585'	Chert
3585	--	3654'	Sand Shale
3654	--	3685'	Dolomite

ELEVATION: 1762 K.B.

FORMATION DATA:


Heebner	3003
Douglas	3064
Brown Lime	3147
Lansing	3172
Base K.C.	3445
Viola	3548
Simpson Sd.	3595
Arbuckle	3654

RECEIVED
STATE CORPORATION COMMISSION
MAY 29 1963
CONSERVATION DIVISION
Wichita, Kansas

AFFIDAVIT

STATE OF KANSAS
COUNTY OF BARTON) ss.

L. O. Chubb, of lawful age, does swear that the facts and statements herein contained are true and correct to the best of his knowledge.

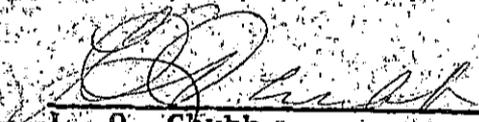
L. O. Chubb

Subscribed and sworn to before me this 28th day of May, 1963.

My Commission Expires:
June 24, 1963


Clair E. Stinson
NOTARY PUBLIC