


WELL PLUGGING RECORD

Give All Information Completely
Make Required Affidavit
Mail or Deliver Report to:
Conservation Division
State Corporation Commission
212 No. Market
Wichita, Kansas

NORTH

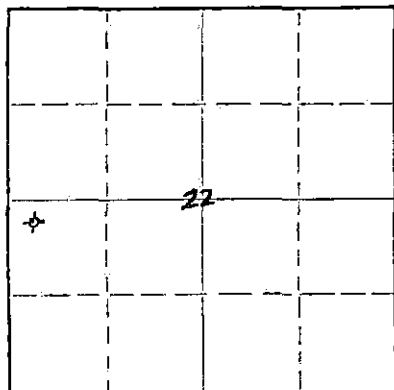

Locate well correctly on above
Section Plat

Reno County, Sec. 22 Twp. 22S Rge. (X) 10 (W)
Location as "NE/CNWxSWx" or footage from lines NW NW SW
Lease Owner Rains & Williamson Oil Co., Inc.
Lease Name SANKEY Well No. 1
Office Address 1425 Wichita Plaza - Wichita, Kansas 67202
Character of Well (completed as Oil, Gas or Dry Hole) Dry Hole
Date well completed 3-24 19 67
Application for plugging filed 3-24 19 67
Application for plugging approved 3-24 19 67
Plugging commenced 3-24 19 67
Plugging completed 3-24 19 67
Reason for abandonment of well or producing formation No oil or gas found
in commercial quantities.
If a producing well is abandoned, date of last production -- 19 --
Was permission obtained from the Conservation Division or its agents before plugging was commenced? Yes

Name of Conservation Agent who supervised plugging of this well Mr. Gilbert Toman, Holyrood, Kansas
Producing formation None Depth to top Bottom Total Depth of Well 3690 Feet
Show depth and thickness of all water, oil and gas formations.

OIL, GAS OR WATER RECORDS

CASING RECORD

FORMATION	CONTENT	FROM	TO	SIZE	PUT IN	PULLED OUT
				8-5/8"	277	-0-

Describe in detail the manner in which the well was plugged, indicating where the mud fluid was placed and the method or methods used in introducing it into the hole. If cement or other plugs were used, state the character of same and depth placed, from feet to feet for each plug set.

Filled hole to 270'. Set solid bridge and cemented with 25 sacks. Filled hole with mud to 40' and set solid bridge, capped with 10 sacks. Plugging completed at 1:30 P.M., 3-24-67.

RECEIVED
STATE CORPORATION COMMISSION
3-28-67

MAR 28 1967

CONSERVATION DIVISION
Wichita, Kansas

(If additional description is necessary, use BACK of this sheet)
Name of Plugging Contractor Rains & Williamson Oil Co., Inc.
Address 1425 Wichita Plaza Bldg. - Wichita, Kansas 67202

STATE OF KANSAS, COUNTY OF SEDGWICK, ss.
Wilson Rains

(owner or operator) of the above-described well, being first duly sworn on oath, says: That I have knowledge of the facts, statements, and matters herein contained and the log of the above-described well as filed and that the same are true and correct. So help me God.

(Signature) Wilson Rains
1425 Wichita Plaza - Wichita, Kansas
(Address)

SUBSCRIBED AND SWORN TO before me this 27th day of March, 1967

My commission expires March 3, 1970

Mary J. Brown
Notary Public.

ROTARY DRILLING LOG

Operator: Rains & Williamson
Oil Co., Inc.
#1 SANKEY
NW NW SW Sec. 22-22S-10W
Reno County, Kansas

Contractor: Rains & Williamson
Oil Co., Inc.
Commenced: 3-16-67
Completed: 3-24-67

Remarks: Set 8-5/8" surface
casing at 277' w/
200 sacks GL-3.

Formations:

Sand	235'
Shale and Red Beds	277'
Red Beds	383'
Anhydrite	402'
Shale	535'
Shale and Shells	1260'
Lime and Shale	1800'
Shale and Shells	1960'
Shale	2340'
Shale and Lime	2775'
Lime and Shale	3130'
Lime	3400'
Lime and Conglomerate	3485'
Lime and Shale	3545'
Lime	3565'
Lime and Sand	3595'
Shale	3635'
Arbuckle	3690'
Rotary Total Depth (D & A)	3690'


RECEIVED
OIL CORPORATION COMMISSION
MAR 28 1967
3-28-67
CONSERVATION DIVISION
Wichita, Kansas

We certify the above log is
true and correct to the best of
our knowledge and belief.

RAINS & WILLIAMSON OIL CO., INC.


Wilson Rains

Subscribed and sworn to before me, a Notary Public in and for the State of
Kansas, County of Sedgwick, this 27th day of March, 1967.


Mary J. Brown Notary Public

My Commission Expires: 3-3-70