


STATE OF KANSAS  
 STATE CORPORATION COMMISSION  
 Give All Information Completely  
 Make Required Affidavit  
 Mail or Deliver Report to:  
 Conservation Division  
 State Corporation Commission  
 211 No. Broadway  
 Wichita, Kansas

15-155-00006-0000

WELL PLUGGING RECORD

NORTH

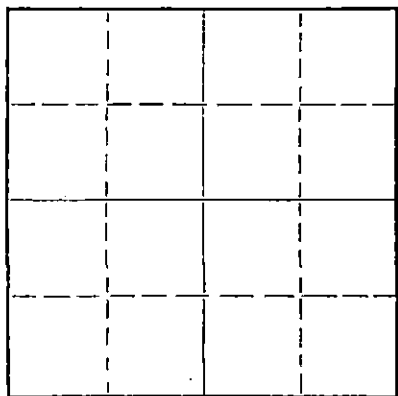

Locate well correctly on above Section Flat

Reno County, Sec. 1 Twp. 23S Rge. 5 (W)  
 Location as "NE/CNW/SW" or footage from lines NE NW SW  
 Lease Owner El Dorado Refining Company  
 Lease Name Swanson "A" Well No. 1  
 Office Address 306 Koch Bldg, Wichita, Kansas  
 Character of Well (completed as Oil, Gas or Dry Hole) Dry hole  
 Date well completed August 16, 1956  
 Application for plugging filed August 15, 1956  
 Application for plugging approved August 15, 1956  
 Plugging commenced August 15, 1956  
 Plugging completed August 16, 1956  
 Reason for abandonment of well or producing formation Dry hole

If a producing well is abandoned, date of last production 19  
 Was permission obtained from the Conservation Division or its agents before plugging was commenced? Yes - orally

Name of Conservation Agent who supervised plugging of this well Ruel Duerkee  
 Producing formation \_\_\_\_\_ Depth to top \_\_\_\_\_ Bottom \_\_\_\_\_ Total Depth of Well 3991 Feet  
 Show depth and thickness of all water, oil and gas formations.

OIL, GAS OR WATER RECORDS

CASING RECORD

FORMATION	CONTENT	FROM	TO	SIZE	PUT IN	PULLED OUT
Surface		0	213	13 3/8	213	none
Surface		0	731	8 5/8"	731	none

Describe in detail the manner in which the well was plugged, indicating where the mud fluid was placed and the method or methods used in introducing it into the hole. If cement or other plugs were used, state the character of same and depth placed, from \_\_\_\_\_ feet to \_\_\_\_\_ feet for each plug set.

Filled hole with heavy mud, set plug with 15 sax cement at 250', filled with heavy mud & set plug with 5 sax cement at 20', filled with mud to surface, leveled location.

RECEIVED  
 STATE CORPORATION COMMISSION  
 AUG 13 1956  
 15-155-56  
 CONSERVATION DIVISION  
 WICHITA, KANSAS

(If additional description is necessary, use BACK of this sheet)

Name of Plugging Contractor Ben F. Brack Oil Co., Inc.  
 Address 310 Brown Building, Wichita, Kansas

STATE OF Kansas, COUNTY OF Sedgwick, ss.  
 Bernard D. Grant (employee of owner) or (owner or operator) of the above-described well, being first duly sworn on oath, says: That I have knowledge of the facts, statements, and matters herein contained and the log of the above-described well as filed and that the same are true and correct. So help me God.

(Signature) Bernard D. Grant  
 310 Brown Bldg., Wichita, Kansas  
 (Address)

SUBSCRIBED AND SWORN TO before me this 17th day of August, 1956

My commission expires 1/27/60

Notary Public.

PLUGGING  
 FILE SEC. 1 T. 23. R. 5W  
 BOOK PAGE 91 LINE 10

15-155-00006-0000

BEN F. BRACK OIL COMPANY, INC.  
310 Brown Building  
Wichita, Kansas

DRILLING TIME LOG

El Dorado Refining Co.  
El Dorado, Kansas

Swanson "A" #1  
NE NW SW Sec. 1-23S-5W  
Reno County, Kansas

Started 7-28-56  
Completed 8-16-56

Soil, sand & shale	0	85
Shale & Shells		214
Shale		230
Shale & Lime		430
Salt		470
Salt & Shale		655
Salt, shale & shells		732
Sandy lime & shale		885
Lime & shale		1490
Shale & Lime		1690
Lime & shale		2195
Shale & lime		2435
Lime & shale		2530
Shale & Lime		2760
Lime & shale		2959
Lime, shale & chert		3007
Lime		3075
Lime & shale		3120
Lime		3211
Shale & lime		3267
Lime & shale		3319
Lime		3363
Shale & lime		3435
Lime & Shale		3502
Lime & chert		3689
Lime & shale		3840
Sandy lime		3860
Sandy lime & shale		3920
Lime & shale		3961
Lime		3984
Sandy lime		3991 TD

CASING RECORD

213' of 13 3/8"  
731' of 8 5/8"

RECEIVED  
STATE COMMISSION  
LONES PATION DIVISION  
WICHITA, KANSAS

Above depths denote bottom of formations.

To the best of my knowledge the above is a true and correct statement of the depths of formations found.

BEN F. BRACK OIL COMPANY, INC.

By Bernard A. Grant

Witnessed:

Emil E. Bowen

Dated August 17, 1956

PLUGGING  
FILE SEC. 1 T 23 R 5W  
BOOK PAGE 91 LINE 10

WELL LOG BUREAU--KANSAS GEOLOGICAL SOCIETY  
500 East Mirdock, Wichita, Kansas

COPY


15-155-00006-0000

Company- EL DORADO REFINING CO.  
Farm- Swanson "A" No. 1

SEC. 1 T. 23 R. 5N  
NE NW SW

Total Depth, 3991:  
Comm. 7-28-56 Comp. 8-16-56  
Shot or Treated.  
Contractor.  
Issued, 9-29-56

County Recd KANSAS

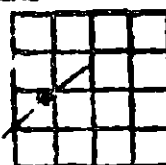

Elevation, 16021

Production, Dry

CASINO:

8 5/8" @731'  
13 3/8" @213'

Figures indicate Bottom of Formations.

soil, sand & shale	85
shale & shells	214
shale	230
shale & lime	430
salt	470
salt & shale	655
salt, shale & shells	732
sandy lime & shale	885
lime & shale	2959
lime, shale & chert	3007
lime	3075
lime & shale	3120
lime	3211
lime & shale	3319
lime	3363
lime & shale	3502
lime & chert	3689
lime & shale	3840
sandy lime	3860
sandy lime & shale	3920
lime & shale	3961
lime	3984
sandy lime	3991

Total Depth

TOPS:	
Lansing	2804
Baso/Kansas City	3220
Mississippi	3465
Kinderhook	3698
Hunton	3828
Viola	3950
Simpson	3972

RECEIVED  
STATE CORPORATION COMMISSION

JUN 26 1956

CONSERVATION DIVISION  
Wichita, Kansas

T.D. 3992

Plugged under supervision Ruel Durkee  
Plug @ 250 ft - 15 sacks cement  
" 20 ft - 5 sacks "