

WELL PLUGGING RECORD

Give All Information Completely
Make Required Affidavit
Mail or Deliver Report to:
Conservation Division
State Corporation Commission
211 No. Broadway
Wichita, Kansas

Reno County, Sec. 1 Twp. 23 Rge. 5 (E) (W) X

Location as "NE/CNW/SW" or footage from lines NE NW SW

Lease Owner Leben Drilling, Inc.

Lease Name Swanson Well No. 1

Office Address P. O. Box 486 Great Bend, Kansas

Character of Well (completed as Oil, Gas or Dry Hole)

Date well completed 19

Application for plugging filed 5-18-64 19

Application for plugging approved 5-18-64 19

Plugging commenced 6-7-64 19


Plugging completed 6-9-64 19

Reason for abandonment of well or producing formation

Dry

If a producing well is abandoned, date of last production 19

Was permission obtained from the Conservation Division or its agents before plugging was commenced? Yes

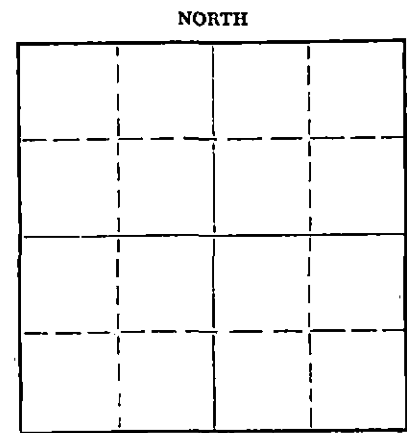

Locate well correctly on above Section Plat

Name of Conservation Agent who supervised plugging of this well Gilbert J. Toman

Producing formation Depth to top Bottom Total Depth of Well 4029 Feet

Show depth and thickness of all water, oil and gas formations.

OIL, GAS OR WATER RECORDS

CASING RECORD

FORMATION	CONTENT	FROM	TO	SIZE	PUT IN	PULLED OUT
				8 5/8	731	None
				5 1/2	None	3046

Describe in detail the manner in which the well was plugged, indicating where the mud fluid was placed and the method or methods used in introducing it into the hole. If cement or other plugs were used, state the character of same and depth placed, from feet to feet for each plug set.

Cleaned out cellar. Rigged up unit. Sanded to 3820' and 5 sacks of cement. Rigged up jacks. Working pipe. Shot pipe at 3418'. Working pipe. Shot pipe at 3220'. Working pipe.

Shot pipe at 3028'. Pulling pipe.

Pulling pipe. Plugging well at 700' and 20 sacks of cement. Mudded 200' and 20 sacks of cement. Mudded 30' and 10 sacks of cement.

RECEIVED
STATE CORPORATION COMMISSION

JUN 17 1964
6-17-64
CONSERVATION DIVISION
Wichita, Kansas

(If additional description is necessary, use BACK of this sheet)

Name of Plugging Contractor Forbes Casing Pulling, Inc.

Address P. O. Box 221 Great Bend, Kansas

STATE OF Kansas, COUNTY OF Barton, ss.

J. O. Forbes (employee of owner) or (owner or operator) of the above-described well, being first duly sworn on oath, says: That I have knowledge of the facts, statements, and matters herein contained and the log of the above-described well as filed and that the same are true and correct. So help me God.

(Signature) J. O. Forbes

P. O. Box 221 Great Bend, Kansas (Address)

SUBSCRIBED AND SWORN TO before me this 15 day of June 19 64

My commission expires May 27, 1965

Notary Public.