

**Strike out upper line  
when reporting plug-  
ging off formations.**

**NORTH**

A 4x4 grid with a small circle in the top-right cell and a small cross in the center cell.

**Locate well correctly on above  
Section Plat**

Reno County. Sec. 1 Twp. 23 Rge. 5 (W)  
 Location as "NE $\frac{1}{4}$ NW $\frac{1}{4}$ SW $\frac{1}{4}$ " or footage from lines 330' N.L. - 990' E.L. NE, NE, NE  
 Lease Owner. Westgate-Greenland Oil Co.  
 Lease Name. Swanson Well No. #1  
 Office Address. 4706 Bdwy., Kansas City, Mo  
 Character of Well (Completed as Oil, Gas or Dry Hole). D. & A.  
 Date, well completed. July 11<sup>th</sup> 1939  
 Application for plugging filed. July 12<sup>th</sup> 1939  
 Application for plugging approved. July 12<sup>th</sup> 1939  
 Plugging Commenced. July 12<sup>th</sup> 1939  
 Plugging Completed. July 12<sup>th</sup> 1939  
 Reason for abandonment of well or producing formation. Dry Hole

If a producing well is abandoned, date of last production.....193.....  
Was permission obtained from the Conservation Division or its agents before plugging was com-  
menced? Yes.....

Name of Conservation Agent who supervised plugging of this well. Dierky  
Producing formation Simpson Depth to top \_\_\_\_\_ Bottom \_\_\_\_\_ Total Depth of Well 3967 Feet.  
Show depth and thickness of all water, oil and gas formations.


## OIL, GAS OR WATER RECORDS

### CASING RECORD

[illegible]

Describe in detail the manner in which the well was plugged, indicating where the mud fluid was placed and the method or methods used in introducing it into the hole. If cement or other plugs were used, state the character of same and depth placed, from.....feet to .....feet for each plug set.

Hole tilled with heavy mud - bailed mud to 190' from top - dumped 10 sacks cement - bridged hole 12' from top tilled to top with 6 sacks cement - plate welded on top of surface pipe -

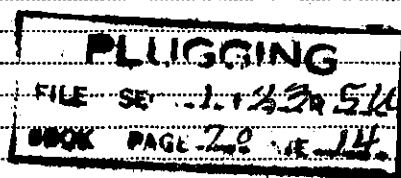

7-26-39  
JUL 23 1939

(If additional description is necessary, use BACK of this sheet)

Correspondence regarding this well should be addressed to Westgate - Greenland Oil Co.  
Address 4706 Bdwy., Kansas City, Mo.

STATE OF Kansas, COUNTY OF Penob, ss.

..... (employee of owner) or (owner or operator) of the above-described well, being first duly sworn on oath, says: That I have knowledge of the facts, statements, and matters herein contained and the log of the above-described well as filed and that the same are true and correct. So help me God. 2 2 2 2

(Signature) Bob Wilson

NOT NOTARIZED

SUBSCRIBED AND SWORN to before me this 25<sup>th</sup> day of July 1939

My commission expires January 26, 1942

17-6058      10-38-5M

*Notary Public.*

15-155-02851-0000

WESTGATE-GREENLAND OIL COMPANYWELL LOGSWANSON NO. 1

Location: Cen. N. Line of NE $\frac{1}{4}$ , Lots 3 and 4  
 Sec. 1, Twp. 23S., Rge. 5W.  
 Reno County, Kansas.

Casing Record:  
 182' of 10" - 80 sacks cement

Commenced: June 20, 1939

Completed: July 12, 1939

Surface sand and clay	0	130	Lime and shale	3185	3225
Sand and shale	130	193	Lime and shale	3225	3280
Red bed	193	210	Shale	3280	3353
Shale and lime shells	210	535	Shale	3353	3414
Shale and shells	535	650	Shale	3414	3474
Anhydrite	650	778	Lime and chat	3474	3512
Anhydrite	778	875	Chat	3512	3565
Anhydrite and shale	875	890	Chat	3564	3573
Shale and shells	890	1025	Chat	3573	3577
Lime	1025	1087	Chat	3577	3595
Lime	1087	1200	Chat	3595	3616
Lime	1200	1260	Chat	3616	3633
Lime	1260	1365	Chat	3633	3648
Lime and shale	1365	1460	Chat	3648	3673
Lime and shale	1460	1550	Chat and lime	3673	3700
Lime and shale	1550	1680	Shale	3700	3712
Lime and shale	1680	1780	Shale	3712	3762
Shale and lime	1780	1860	Shale	3762	3832
Shale and lime	1860	1940	Shale	3832	3890
Lime and shale	1940	2048	Shale	3890	3927
Shale and lime	2048	2119	Shale	3927	3938
Shale and lime	2119	2225	Lime	3938	3952
Lime	2225	2315	Core hole	3952	3961
Lime	2315	2372	Cored	3961	3963
Lime	2372	2455	Cored	3963	3967
Lime	2455	2532			
Shale	2532	2700	TOTAL DEPTH		3967
Lime and shale	2700	2785			
Lime and shale	2785	2845			
Shale and lime	2845	2915	PLUGGED AND ABANDONED		
Lime	2915	2974			
Lime	2974	2998			
Lime and shale	2998	3030			
Lime	3030	3044			
Lime	3044	3090			
Lime and shale	3090	3140			
Lime and shale	3140	3185			

PLUGGING  
 FILE REC-1-22-R SW  
 BOOK PAGE-70-LINE-14

C E R T I F I C A T E

I certify that the above and foregoing is a true and correct copy of log of the Swanson No. 1 well, located in the center of the north line of the Northeast Quarter (NE $\frac{1}{4}$ ), Lots 3 and 4, Section One (1), Township Twenty-three (23) South, Range Five (5) West, Reno County, Kansas, as reflected by Westgate-Greenland Oil Company's files.

Lede Nelson  
 Agent

Subscribed and sworn to before me this 25<sup>th</sup> day of July, 1939.

Ruth Lawrence  
 Notary Public

My Commission expires:

January 26, 1942