


STATE OF KANSAS
STATE CORPORATION COMMISSION

WELL PLUGGING RECORD

Give All Information Completely
Make Required Affidavit
Mail or Deliver Report to
Conservation Division
State Corporation Comm.
245 North Water
Wichita, KS 67202

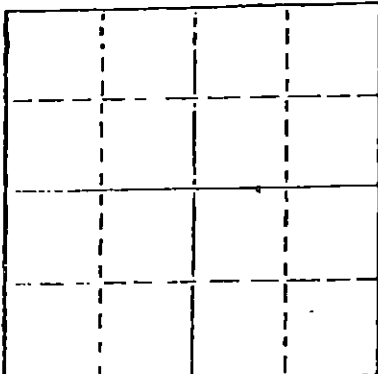

Locate well correctly on above
Section Plat

Reno County, Sec. 1 Twp. 23S Rge. 5 E/W
Location as "NE/CNW $\frac{1}{4}$ SW $\frac{1}{4}$ " or footage from lines
SE SW SW
Lease Owner McGinness Oil Company
Lease Name Swanson Well No. #1
Office Address 1026 Union Center Building Wichita, KS
Character of Well (Completed as Oil, Gas or Dry Hole)

Date Well completed 7-26-81 19
Application for plugging filed 7-26-81 19
Application for plugging approved 7-26-81 19
Plugging commenced 7-26-81 19
Plugging completed 7-26-81 19
Reason for abandonment of well or producing formation

If a producing well is abandoned, date of last production 19

Was permission obtained from the Conservation Division or
its agents before plugging was commenced? yes

Name of Conservation Agent who supervised plugging of this well Tolman
Producing formation Depth to top Bottom Total Depth of Well 3977
Show depth and thickness of all water, oil and gas formations.

OIL, GAS OR WATER RECORDS

CASING RECORD

FORMATION	CONTENT	FROM	TO	SIZE	PUT IN	PULLED OUT
		0	805	8 5/8	805	0

Describe in detail the manner in which the well was plugged, indicating where the mud fluid
was placed and the method or methods used in introducing it into the hold. If cement or other
plugs were used, state the character of same and depth placed, from feet to
feet for each plug set.

Rotary mud to 800'
Plug & 25 sx @800'
Plug & 75 sx @650'
100 sx from 300 to surface
5 sx in rathole'

RECEIVED
STATE CORPORATION COMMISSION
9-14-81
SEP 14 1981

(If additional description is necessary, use BACK of this sheet)

Name of Plugging Contractor Tolman

CONSERVATION DIVISION
Wichita, Kansas

STATE OF Kansas COUNTY OF Sedgwick, ss.
Timothy E Brandt (employee of owner) or (owner or operator)
of the above-described well, being first duly sworn on oath, says: That I have knowledge of
the facts, statements, and matters herein contained and the log of the above-described well
as filed and that the same are true and correct. So help me God.

(Signature)


(Address)

SUBSCRIBED AND SWORN TO before me this 29th day of July, 1981

My commission expires April 21, 1984

Sheryl Modellmog

Notary Public

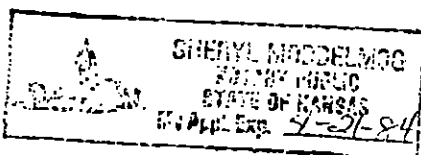

Operator 1

DESIGNATE TYPE OF COMP.: OIL, GAS,
DRY HOLE, SWDW, ETC.:

McGinness Oil Company

Well No.

Lease Name

#1

Swanson

Dry

1 T23S R5 ^{XE}_W SE SW SW Reno County, Kansas

WELL LOG

Show all important zones of porosity and contents thereof; cored intervals, and all drill-stem tests, including depth interval tested, cushion used, time tool open, flowing and shut-in pressures, and recoveries.

SHOW GEOLOGICAL MARKERS, LOGS RUN,
OR OTHER DESCRIPTIVE INFORMATION.

FORMATION DESCRIPTION, CONTENTS, ETC.	TOP	BOTTOM	NAME	DEPTH
Soil	0	10		
Red Rock	10	50		
Shales, red	50	600		
Shales, gray	600	750		
Shale & lime	750	1100		
Lime	1100	1300		
Lime & shale	1300	2050		
Shale w/ lime stks.	2050	2620		
Lime, chalky	2620	2885		
Shale, black	2885	2892	Heeb.	
Shales & sandy shale	2892	3085		
Lime, xln & fossil	3085	3480		
Shales & limey shale	3480	3659		
Chert & cherty lime	3659	3730	Miss.	
Shale	3730	3874	Kh.	
Dolomite & limey dolomite	3874	3974		
Sand	3974	3977		
RTD	3977			

RECEIVED
STATE CORPORATION COMMISSION

SEP 14 1931

USE ADDITIONAL SHEETS, IF NECESSARY, TO COMPLETE WELL RECORD CONSERVATION DIVISION
Wichita, Kansas

Date Received

Signature

General Manager

Title

7-29-81

Date