

**Give All Information Completely**  
**Make Required Affidavit**  
**Mail or Deliver Report to:**

## FORMATION PLUGGING RECORD

**Strike out upper line  
when reporting plug-  
ging off formations.**

**Conservation Division  
State Corporation Commission  
800 Bitting Building  
Wichita, Kansas**

**NORTH**


**Locate well correctly on above  
Section Plat**

Reno.....County. Sec. 3.....Twp. 23-S Rge. 5W-#E.....(W)  
Location as "NE $\frac{1}{4}$ NW $\frac{1}{4}$ SW $\frac{1}{4}$ " or footage from lines SE-Cor-SE $\frac{1}{4}$ -SW $\frac{1}{4}$   
Lease Owner. L. E. Douglass  
Lease Name. Durant Well No. 1  
Office Address. 514- Stamey Hotel-Hutchinson, Kansas  
Character of Well (Completed as Oil, Gas or Dry Hole) Dry Hole  
Date, well completed. June 21- 1938  
Application for plugging filed. June 21- 1938  
Application for plugging approved. June 21- 1938  
Plugging Commenced. June 21- 1938  
Plugging Completed. June 21- 1938  
Reason for abandonment of well or producing formation Dry Hole  
If a producing well is abandoned, date of last production. 193  
Was permission obtained from the Conservation Division or its agents before plugging was commenced?  
Yes

Name of Conservation Agent who supervised plugging of this well Guy Wiirsting  
Producing formation..... Depth to top..... Bottom..... Total Depth of Well 4024 Feet.  
Show depth and thickness of all water, oil and gas formations.



## OIL, GAS OR WATER RECORDS

### CASING RECORD

[illegible]

Describe in detail the manner in which the well was plugged, indicating where the mud fluid was placed and the method or methods used in introducing it into the hole. If cement or other plugs were used, state the character of same and depth placed, from.....feet to .....feet for each plug set.

Hole filled with Rotary Mud from bottom to depth of 217 ft.  
Drove a wood plug at depth of 217 ft (bottom of surface Pipe)  
Covered top of plug with sacks and poured 10 sacks of cement on top.  
Filled surface pipe with mud to within 10 ft of top.  
Bridged hole and filled surface pipe with cement up to level of bottom  
of cellar.

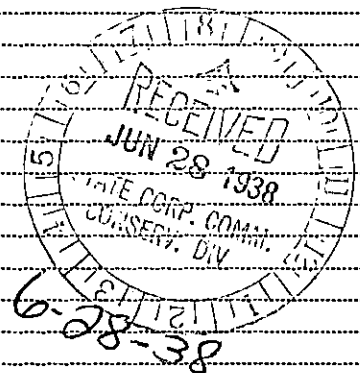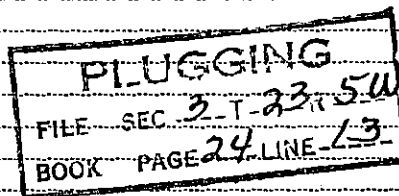

(If additional description is necessary, use BACK of this sheet)

Correspondence regarding this well should be addressed to L. E. Douglass, 514--Stamey Hotel  
Address Hutchinson, Kansas.

STATE OF Kansas, COUNTY OF Reno, ss.  
being first duly sworn on oath, says: That I have knowledge of the facts, statements, and matters herein contained and the log of the above-described well as filed and that the same are true and correct. So help me God.

(Signature) A. M. Collins

510- Cloverdale, Hutchinson, Kansas  
(Address)

SUBSCRIBED AND SWORN to before me this 27 day of June, 19 38

My commission expires June 16- 1941

17-3443

3-38-3M

Notary Public.

## L. E. DOUGLASS

Hutchinson, Kansas

## RECORD OF FORMATIONS

The L.E. Douglass Drg. Company

Durant #1

SE Cor. of SE  $\frac{1}{4}$  of SW  $\frac{1}{4}$ , Sec. 3,

23 S-5W Reno County, Kansas

Form 305-2

FORMATION	TOP	BOTTOM	REMARKS
			Indicate Casing Points, Describe Shows of Oil, Gas and Water, etc.
Sand	0	8	16" O D Casing cemented with 150 sacks cement
Clay and sand	8	40	
Red Bed	40	125	
Red Bed and Gyp	125	203	
Red Rock	203	217	
Red Bed	217	230	<p>15755-02852-0000</p> <p>Laying down drill pipe and tearing down A/C Replacing Derrick</p> <p>Coming out of hole to core Circulate at 3915-3925-3929 feet</p> <p>Circulating at 4010'</p>
	230	307	
Shale	307	675	
Salt	675	762	
Gyp	762	975	
Broken lime and shale	975	1100	
Shale and lime	1100	1206	
Lime	1206	1250	
Lime and shale	1250	1440	
Brown lime	1440	1535	
Broken lime	1535	1625	
Shale and lime shells	1625	1740	
Lime shale	1740	1821	
Lime and shale	1821	1945	
Shale	1945	2026	
Brown Lime-soft	2026	2069	
Broken lime	2069	2150	
Shale and shells	2150	2200	
Lime broken	2200	2247	
Lime	2247	2295	
Sandy lime	2295	2335	
Shale and lime	2335	2365	
Lime-sandy	2365	2400	
Lime-hard	2400	2435	
Lime	2435	2540	
Dark shale	2540	2570	
Broken sand and lime	2570	2592	
Sand	2592	2612	
Lime-sandy	2612	2668	
Lime and shale	2668	2714	
Shale	2714	2755	
Lime and shale	2755	2827	
Lime and shale	2827	2930	
Lime-hard	2930	2940	
Sand-soft	2940	2950	
Lime-broken	2950	2979	
Lime-hard	2979	3024	
Lime	3024	3073	
Lime	3073	3122	
Lime-hard	3122	3133	
Black shale	3133	3136	
Lime	3136	3156	
Lime	3156	3190	
Lime and shale	3190	3307	
Shale and lime shells	3307	3343	
Shale and shells	3390	3435	
Shale	3435	3441	
Conglomerate	3441	3451	
Shale	3451	3458	
Chat	3458	3540	
Chat and dolomite	3540	3571	
Chat	3571	3608	
Chat and lime	3608	3658	
Sticky shale	3658	3664	
Shale	3664	3740	
Shale-blue	3740	3769	
Shale	3769	3801	
Misner sand	3801	3820	
Lime, chert and some dolomite	3820	3848	
Lime and chert	3848	3875	
Shale	3875	3911	
Vilo lime	3911	3929	
Sand	3929	3940	
Cored	3940	3950	
Shale	3950	3970	
Hard sand	3970	3978	
Sand and sandy shale	3978	4010	
Silicious lime	4010	4024	

