


STATE OF KANSAS
STATE CORPORATION COMMISSION

WELL PLUGGING RECORD

Give All Information Completely
Make Required Affidavit
Mail or Deliver Report to:
Conservation Division
State Corporation Commission
800 Bittling Building
Wichita, Kansas

Stafford County, Sec. 8 Twp. 24 Rge. 12 (E) (W) W
Location as "NE/CNW $\frac{1}{4}$ SW $\frac{1}{4}$ " or footage from lines NE NE SE
Lease Owner The El Dorado Refining Company.
Lease Name O'CONNER Well No. 1
Office Address Box 551, El Dorado, Kansas
Character of Well (completed as Oil, Gas or Dry Hole) Dry Hole.
Date well completed 7-30-19 51
Application for plugging filed 8-8-19 51
Application for plugging approved 8-22-19 51
Plugging commenced 8-24-19 51
Plugging completed 8-29-19 51
Reason for abandonment of well or producing formation Dry Hole.

NORTH

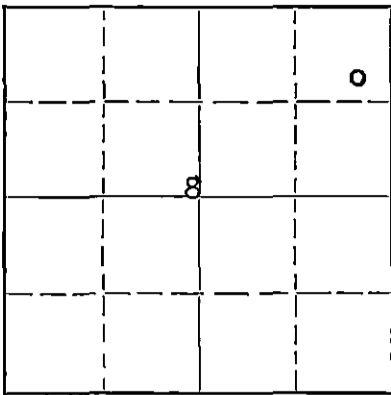

Locate well correctly on above
Section Flat

If a producing well is abandoned, date of last production 19...
Was permission obtained from the Conservation Division or its agents before plugging was com-
menced? Yes

Name of Conservation Agent who supervised plugging of this well C. D. Stough
Producing formation 3914' Depth to top 3914' Bottom Total Depth of Well 3914' Feet
Show depth and thickness of all water, oil and gas formations.

OIL, GAS OR WATER RECORDS

CASING RECORD

Formation	Content	From	To	Size	Put In	Pulled Out
				8-5/8"	264'	000
				5-1/2"	3917'	3361'6"

Describe in detail the manner in which the well was plugged, indicating where the mud fluid was placed and the method or methods used in introducing it into the hole. If cement or other plugs were used, state the character of same and depth placed, from... feet to... feet for each plug set.

Filled hole with sand from 3914' to 3850' - run 5 sacks of cement at 3850' then mudded up to 250' - set bridge and rock to 250' Run 15 sacks of cement at 250' - mudded to 30' - ran 10 sacks of cement to cap.

STATE CORPORATION COMMISSION

SEP 5 1951 9-5-51

(If additional description is necessary, use BACK of this sheet)

Correspondence regarding this well should be addressed to The El Dorado Refining Company
Address Box 209 - Russell, Kansas

STATE OF KANSAS, COUNTY OF RUSSELL, ss.

Verrel J. Brack

(employee of owner) or (owner or operator) of the above-described well, being first duly sworn on oath, says: That I have knowledge of the facts, statements, and matters herein contained and the log of the above-described well as filed and that the same are true and correct. So help me God.

(Signature)

Verrel J. Brack

(Address)

SUBSCRIBED AND SWORN TO before me this 4 day of Sept., 19 51

Herbert B. [Signature]

Notary Public.

My commission expires 8-13-55

8789-122
107-26

THE EL DORADO REFINING COMPANY

EL DORADO, KANSAS

WELL LOG ----- O'CONNOR # 1.

Location - NE/4 NE/4 SE/4 of Section 8-24-12W, Stafford County, Kans.

Owner - The El Dorado Refining Co.
Rotary Drilling Contractor - Sterling Drilling Company
Cable Tools Contractor

Commenced - 6-25-51
Completed - 7-10-51 (w/r)
" - 7-30-51 (WC/t.)

Total Depth - 3914' (w/r)
" " - 3914' (w/ct)

LOG

0 - 80	Sand
80 - 264	Shale and Shells
264 - 675	Red Bed
675 - 705	Anhydrite
705 - 825	Shale
825 - 1375	Shale and Shells
1375 - 1765	Shale and Lime
1765 - 2350	Lime
2350 - 3010	Lime and Shale
3010 - 3325	Lime
3325 - 3425	Shale and Lime
3425 - 3495	Shale
3495 - 3850	Lime
3850 - 3853	Shale
3853 - 3914	Viola Lime

3889 - 3893

3878 - 3882

3857 - 3867

3914 Total Dept.

CASING RECORD

264' of 8-5/8" Surface Pipe
Cemented with 150 Sacks.
(2 Sacks Calcium Chloride)

3917' of 5 1/2" OD Casing
Cemented with 50 Sacks Cement

PRODUCTION

Perforated from 3889 to 3893 with
16 holes. Perforated from 3878 to
3882 with 16 holes.
Squeezing perforations from 3878 to
3882, squeezed with 250 sacks,
packer set at 3850' standing pres-
sure 2500#.
Perforated with 70 shots from 3857
to 3867, acidized W/100 gals.

D. & A.

