


STATE OF KANSAS
STATE CORPORATION COMMISSION

Form CP-4

Give All Information Completely
Make Required Affidavit
Mail or Deliver Report to:
Conservation Division
State Corporation Commission

WELL PLUGGING RECORD

P. O. Box 17027
Wichita, Kansas 67217
NORTH

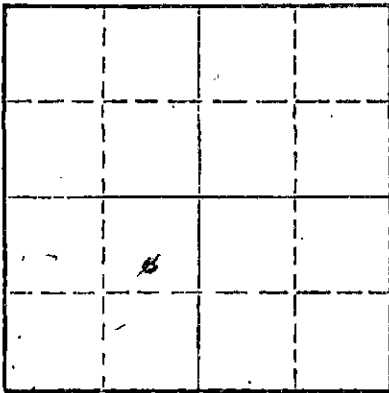

Locate well correctly on above
Section Flat

Stafford County, Sec 8 Twp 24 Rge 12 (E) (W)
Location as "NE/CNWSW" or footage from lines C S/2 NE SW
Lease Owner Addis Oil Operations
Lease Name Parks #1 Well No.
Office Address Wichita, Kansas 67208
Character of Well (completed as Oil, Gas or Dry Hole)
Date well completed 19
Application for plugging filed 19
Application for plugging approved 19
Plugging commenced 5/16/73 19
Plugging completed 5/18/73 19
Reason for abandonment of well or producing formation depleted.

If a producing well is abandoned, date of last production 19
Was permission obtained from the Conservation Division or its agents before plugging was commenced? yes

Name of Conservation Agent who supervised plugging of this well Biberstein
Producing formation Depth to top Bottom Total Depth of Well 3869 Feet
Show depth and thickness of all water, oil and gas formations.

OIL, GAS OR WATER RECORDS

CASING RECORD

FORMATION	CONTENT	FROM	TO	SIZE	PUT IN	PULLED OUT
				8-5/8	207	none
				5 1/2	3865	2027'

Describe in detail the manner in which the well was plugged, indicating where the mud fluid was placed and the method or methods used in introducing it into the hole. If cement or other plugs were used, state the character of same and depth placed, from feet to feet for each plug set.

Checked hole, pushed plug to 3500' and ran 10' of sand. Dumped 5 sacks cement. Loaded hole, shot pipe at 2019', 2798', 2600', 2404', 2219', 2120', 2022', pulled 65 joints. Cut head off and had 8-5/8 collar welded on. Allied squeezed well with 2 sacks hulls, 15 sacks gel and 100 sacks com. cement.

PLUGGING COMPLETE.

RECEIVED
STATE CORPORATION COMMISSION
6-11-73
JUN 11 1973
CONSERVATION DIVISION
Wichita, Kansas

(If additional description is necessary, use BACK of this sheet)
Name of Plugging Contractor KELSO CASING PULLING
Address CHASE, KANSAS

STATE OF KANSAS, COUNTY OF RICE, ss.
R. DARRELL KELSO (employee of owner) or (owner or operator) of the above-described well, being first duly sworn on oath, says: That I have knowledge of the facts, statements, and matters herein contained and the log of the above-described well as filed and that the same are true and correct. So help me God.

(Signature) R. Darrell Kelso
R. Darrell Kelso, CHASE, KANSAS
(Address)

SUBSCRIBED AND SWORN to before me this 21st day of May, 1973

My commission expires February 18, 1976

Arlyen M. Yerton
Arlyen M. Yerton Notary Public
in and for State of Kansas

WELL LOG BUREAU—KANSAS GEOLOGICAL SOCIETY
508 East Murdock, Wichita, Kansas


COPY

Company- BARNETT OIL CO.
Farm- Parks No. 1

SEC. 8 T. 24 R. 12W
C S/2 NE SW

Total Depth. 3869'
Comm. 7-1-61 Comp. 7-28-61
Test or Treated.
Contractor.
Cased. 9-30-61

County Stafford
KANSAS

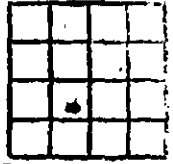

Elevation. 1883' RB

Production. 50 BOPD

CASING:

8 5/8" 207' cem w/200 sx.
5 1/2" 3865' cem w/125 sx.

Figures Indicate Bottom of Formations.

clay	55
sand	140
shale	211
shale & shells	330
red bed & sand	625
red bed	675
Anhydrite	705
shale	750
sand & shale	1480
shale	1875
shale & lime shell	2060
lime & shale	3525
lime	3869
Total Depth	

TOPS: SCOUT	
Heebner	3317
Brown Lime	3468
Kansas City	3498
Base Kansas City	3826
Viola	3864

RECEIVED
STATE CORPORATION COMMISSION
MAY 15 1973
CONSERVATION DIVISION
Wichita, Kansas